

**MISSISSIPPI
BOARD OF WATER COMMISSIONERS**
416 North State Street
Jackson, Mississippi 39201

CODED

WATER WELL DRILLERS LOG

Harrison
M 213
5-67

May 14, 67 19 M & B Drilling Co. Harrison
date well completed firm name county well located

LANDOWNER: Mr. Hall - Mr. Bonstell - Mr. Biloxi - Miss Brodie Rd.
(mailing address)

WELL LOCATION:
sec. 18 T. 7 S. R. 9 W.
2 miles West of DeBrewville
(distance) (direction) (nearest town)

WELL PURPOSE: Home
(home, irrigation, municipal, industrial)

WELL COMPLETION DATA:

(1) diameter (inches) 4 X 2

(2) total depth (feet) 550 FT

(3) static water level (feet) 30 below top of ground.

(4) casing PVC Plastic - 541 FT.
(material) (depth)

4 X 2 if telescope see back.
(size)

(5) screen 9 FT 541
(length) (depth to top)

2" PVC & Sand Pac
(size) (material)

(6) pump 3 8
(HP) (yield gpm)

220 Volt
(type power)


(7) electric log No
(yes or no)

(organization running log)

(8) how well bottom plugged

description of formations encountered	from	to
Surface Sandy Clay	0	6
White Clay	6	11
White Sand	11	13
White Clay	13	28
" " Brown Heavy Clay	28	35
Gray Clay	35	45
Gray Sand & Clay Breach	45	55
Sand & Old Swamp Muck	55	62
Sand	62	66
Light Green Clay	66	72
Brown Sulfur Clay Breach	72	104
Blue Clay	104	130
Gray white yellow Clay	130	193
Sand - Gray	193	197
Blue Clay	197	267
Sand	267	275
Blue Clay	275	470
Fine Sand	470	500
Good Medium Sand	500	550
Bottomed still cutting Sand		
Old Well - 600 Ft.		

CODED

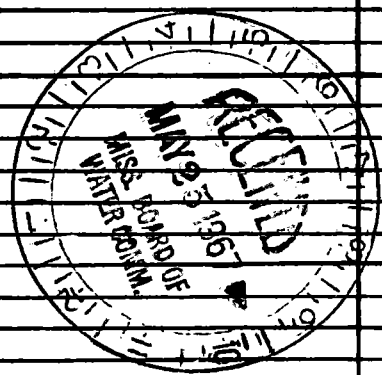

DRILLERS REMARKS:

If well telescopes please sketch and show depths.

GROUND LEVEL

Notes: How

			X

SECTION 18

Please indicate well location X.

ADDITIONAL INFORMATION

If more than one screen, show locations of each on sketch.