

Harrison
M214
5-67

MISSISSIPPI
 BOARD OF WATER COMMISSIONERS
 416 North State Street
 Jackson, Mississippi 39201
 WATER WELL DRILLERS LOG

CODED

5-3 1967 Switzer Well Co. Harrison
 date well completed firm name county well located

LANDOWNER: Mrs. Husley
Just off Hwy. 67 1/2 miles
SE. Cedar Lake Rd. Intersection
Rt. 1 Box 545 Biloxi
 (mailing address)


description of formations encountered	from	to
clay	0	10
sand	10	41
gravel	41	62
band + clay streaks	62	82
clay	82	264
sand	264	266
good sand	266	305

WELL LOCATION:
 sec. 1 T. 7 S. R. 10 W.
10 miles NW of Biloxi
 (distance) (direction) (nearest town)

WELL PURPOSE: Home
 (home, irrigation, municipal, industrial)

- WELL COMPLETION DATA:
- (1) diameter (inches) 2
 - (2) total depth (feet) 305
 - (3) static water level (feet) 5 below top of ground.
 - (4) casing gal. steel 295'
 (material) (depth)
2" If telescope see back.
 (size)
 - (5) screen 10' 295'
 (length) (depth to top)
2" sga ss. on pipe
 (size) (material)
 - (6) pump 1/2 8.5
 (HP) (yield gpm)
electric
 (type power)
 - (7) electric log No
 (yes or no)
 (organization running log)
 - (8) how well bottom plugged back
pressure valve

CODED

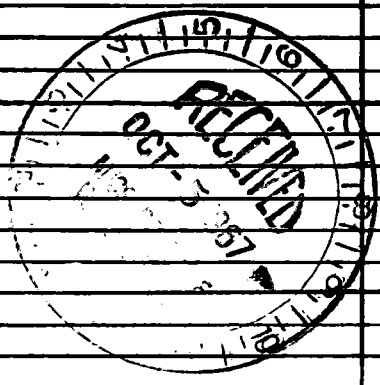

DRILLERS REMARKS:

If well telescopes please sketch and show depths.

GROUND LEVEL

			X

SECTION 1

Please indicate well location X.

ADDITIONAL INFORMATION

If more than one screen, show locations of each on sketch.