

MISSISSIPPI
BOARD OF WATER COMMISSIONERS
416 North State Street
Jackson, Mississippi 39201

CODED

WATER WELL DRILLERS LOG

Harrison
M 215
5-67

5-2 1967 Switzer Well Co. Harrison
date well completed firm name county well located

LANDOWNER: Fred Debose
Intersection Dopp's Ferry Rd +
 Hwy 67. Spadding Ridge Sub.
Pk 1 Box 89 Biloxi, Miss.
(mailing address)

description of formations encountered	from	to
clay	0	10
sand	10	42
clay	42	52
sand	52	62
clay	62	121
sand	121	130
clay	130	166
clay + sand streaks	166	187
clay	187	207
fine sand	207	228
fair sand	228	236
clay	236	281
fine sand	281	291
sand	291	299
clay	299	342
sand	342	350
medium sand	350	370
good sand	370	409

WELL LOCATION:
sec. 8 T. 7 S. R. 9 W.
5 miles N of BILOXI
(distance) (direction) (nearest town)


WELL PURPOSE: Home
(home, irrigation, municipal, industrial)

WELL COMPLETION DATA:

- (1) diameter (inches) 2
- (2) total depth (feet) 409
- (3) static water level (feet) 49 below top of ground.
- (4) casing gal. steel 399'
(material) (depth)
- 2"
(size) if telescope see back.
- (5) screen 10' 399'
(length) (depth to top)
- 8ga. ss on pipe
(size) (material)
- (6) pump 1/2 8.5
(HP) (yield gpm)
- electric
(type power)
- (7) electric log no
(yes or no)
- (organization running log)
- (8) how well bottom plugged back
pressure valve


DRILLERS REMARKS:

CODED

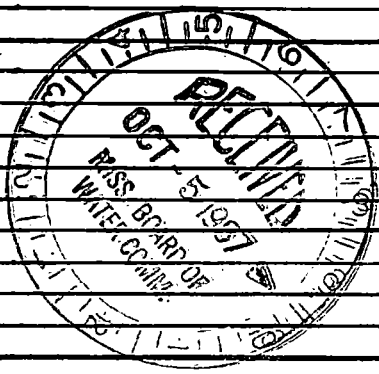

If well telescopes please sketch and show depths.

GROUND LEVEL

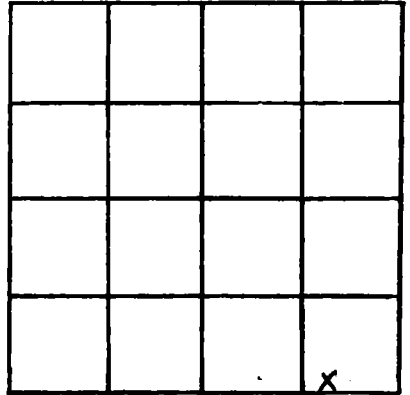

SECTION 8

Please indicate well location X.

ADDITIONAL INFORMATION

If more than one screen, show locations of each on sketch.