

HARRISON  
M 214  
6-67

MISSISSIPPI  
 BOARD OF WATER COMMISSIONERS  
 416 North State Street  
 Jackson, Mississippi 39201

WATER WELL DRILLERS LOG

**CODED**

6-23 1967 Sutton Well Works Harrison  
 date well completed firm name county well located

LANDOWNER: HARLAN MONROE  
321 Race Track Road  
Biloxi Miss  
 (mailing address)

WELL LOCATION:  
 sec. 22 T. 7 S. R. 9 W.  
1 miles N of Biloxi  
 (distance) (direction) (nearest town)

WELL PURPOSE: Home  
 (home, irrigation, municipal, industrial)

WELL COMPLETION DATA:

- (1) diameter (inches) 2
- (2) total depth (feet) 359
- (3) static water level (feet) \_\_\_\_\_ below above top of ground.
- (4) casing Galv. 349'  
 (material) (depth)  
2" if telescope see back.  
 (size)
- (5) screen 10' 349'  
 (length) (depth to top)  
2" Stainless steel  
 (size) (material)
- (6) pump Unknown  
 (HP) (yield gpm)  
 (type power)
- (7) electric log no  
 (yes or no)  
 (organization running log)
- (8) how well bottom plugged B.P. Valve

description of formations encountered	from	to
Clay	0	18
Sand	18	38
Clay	38	52
Sand	52	67
Clay	67	253
Sand	253	291
Clay	291	339
Sand	339	359


**CODED**



DRILLERS REMARKS:

If well telescopes please sketch and show depths.

GROUND LEVEL

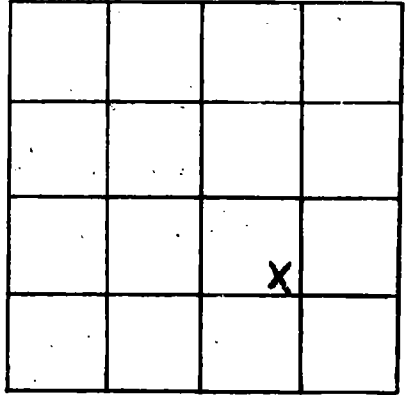

SECTION 22

Please indicate well location X.

ADDITIONAL INFORMATION

If more than one screen, show locations of each on sketch.