

**HARRISON**  
**M 218**  
**5-1-72**

MISSISSIPPI  
 BOARD OF WATER COMMISSIONERS  
 416 North State Street  
 Jackson, Mississippi 39201

WATER WELL DRILLERS LOG

**CODE**

5-1 1972 date well completed  
 Switzer Well Company firm name  
 Harrison county well located

LANDOWNER: G.N. (Nicky) Creel  
657 Bohn  
Biloxi, Miss. 39531  
 (mailing address)

WELL LOCATION:  
 sec. 18 T. 7 S. R. 12 W.  
1/2 miles N of Biloxi  
 (distance) (direction) (nearest town)

WELL PURPOSE: home  
 (home, irrigation, municipal, industrial)

- WELL COMPLETION DATA:
- diameter (inches) 2"
  - total depth (feet) 346'
  - static water level (feet) 22'06" <sup>below</sup> <sub>above</sub> top of ground.
  - casing galv. 346'  
 (material) (depth)  
4"  
 (size) If telescope see back.
  - screen 20' 326'  
 (length) (depth to top)  
008 stainless steel  
 (size) (material)
  - pump 1 2.0  
 (HP) (yield gpm)  
ELECT  
 (type power)
  - electric log —  
 (yes or no)  
—  
 (organization running log)
  - how well bottom plugged back  
pressure valve

description of formations encountered	from	to
Clay	0	23
Clay-sand str.	23	44
sand-geo gravel	44	65
Sand	65	70
Clay	70	97
Sand	97	108
shell-sand mix.	108	129
sand	129	140
Clay	140	236
fine sand	236	267
Clay	267	278
Sand, fine	278	295
clay	295	311
Sand, fine	311	346

**CODED**

JUL 1 1972

MISS. Bd. of  
 WATER COMMISSIONERS

DRILLERS REMARKS:

If well telescopes please sketch and show depths.

GROUND LEVEL

105' 4" GALV

105'


Bell Reduced

20' 2" GALV

326'

20' 2" STAINLESS STEEL  
W/ WIRE WRAPPED  
WELL SCREEN

346'

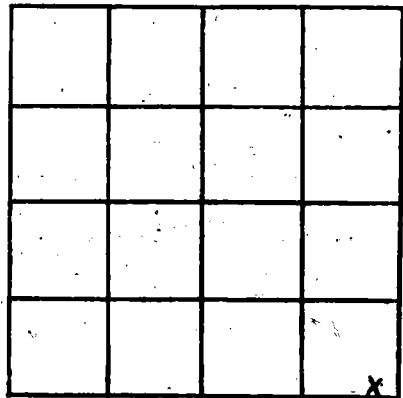

SECTION 10

Please indicate well location X.

ADDITIONAL INFORMATION

If more than one screen, show locations of each on sketch.