

Harrison  
M 220  
7-67

MISSISSIPPI  
BOARD OF WATER COMMISSIONERS  
416 North State Street  
Jackson, Mississippi 39201  
WATER WELL DRILLERS LOG

**CODED**

7-13 1967 date well completed Switzer Well Co. firm name Harrison county well located

LANDOWNER: Martha Willhoft  
195 Reservoir Road  
Biloxi, Miss. 39532  
(mailing address)

WELL LOCATION:  
sec. 22 T. 7 A. R. 9 S. W.  
2 miles N of Biloxi  
(distance) (direction) (nearest town)


WELL PURPOSE: Home  
(home, irrigation, municipal, industrial)

WELL COMPLETION DATA:

- (1) diameter (inches) 2
- (2) total depth (feet) 359
- (3) static water level (feet) 20 below top of ground. above
- (4) casing gal. steel, 348' (material) (depth)  
2" If telescope see back. (size)
- (5) screen 10' (length), 348' (depth to top)  
8 ga. (size), SS on pipe (material)
- (6) pump 1/2 (HP), 8.5 (yield gpm)  
electric (type power)
- (7) electric log No (yes or no)  
(organization running log)
- (8) how well bottom plugged Back Pressure valve

description of formations encountered	from	to
Clay	0	22
sand	22	38
clay	38	43
Clay + sand streaks	43	64
fine sand	64	85
band	85	100
fine clay	100	105
clay + sand streaks	105	126
clay	126	207
clay + sand streaks	207	228
clay	228	262
fine sand	262	287
band	287	297
fine clay	297	308
clay + sand streaks	308	328
fine sand	328	349
good sand	349	359

**CODED**

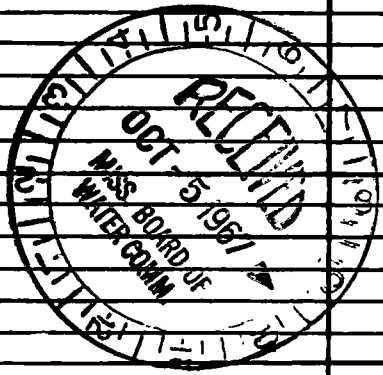

DRILLERS REMARKS:

