

Harrison
M 222
7-67

MISSISSIPPI
 BOARD OF WATER COMMISSIONERS
 416 North State Street
 Jackson, Mississippi 39201

CODED

WATER WELL DRILLERS LOG

HARRISON

7-6 1967 Switzer Well Co. Harrison
 date well completed firm name county well located

LANDOWNER: Robert Savoy
Happy Landing Road
Biloxi, Miss.
 (mailing address)

WELL LOCATION:
 sec 21 T 7 S R 9 W
2 miles N of Biloxi
 (distance) (direction) (nearest town)

WELL PURPOSE: Home
 (home, irrigation, municipal, industrial)

WELL COMPLETION DATA:


- (1) diameter (inches) 2
- (2) total depth (feet) 678
- (3) static water level (feet) 15 below top of ground.
- (4) casing gal. steel, 663'
 (material) (depth)
2" if telescope see back.
 (size)
- (5) screen 15', 663'
 (length) (depth to top)
8 ga., SS on pipe
 (size) (material)
- (6) pump 3/4 20
 (HP) (yield gpm)
electric
 (type power)
- (7) electric log No
 (yes or no)

(organization running log)

(8) how well bottom plugged Back pressure valve

description of formations encountered	from	to
clay	0	29
sand	29	49
clay streaks	49	59
clay	59	80
clay + sand streaks	80	102
clay	102	123
clay + sand streaks	123	165
clay	165	206
clay + sand streaks	206	226
clay	226	372
sand	372	382
clay	382	408
sand	408	414
clay	414	433
clay + sand streaks	433	454
clay	454	471
sand	471	484
clay	484	552
sand	552	564
clay	564	572
sand	572	575
sand + clay streaks	575	596
clay	596	611
fine sand	611	646
good sand	646	678

CODED

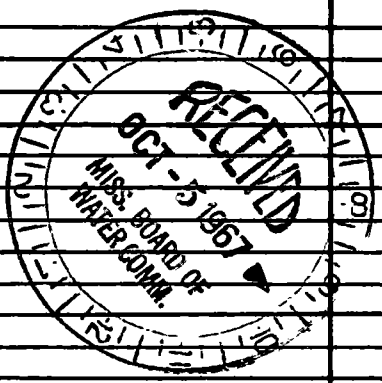

DRILLERS REMARKS:

