

Harrison
M 224
7-67

MISSISSIPPI
 BOARD OF WATER COMMISSIONERS
 416 North State Street
 Jackson, Mississippi 39201


CODED

WATER WELL DRILLERS LOG

7-14 1967 Switzer Well Co. Harrison
 date well completed firm name county well located

| LANDOWNER | description of formations encountered | from | to |
|--|---------------------------------------|-------------|-------------|
| <u>Leno Parker</u> | <u>clay</u> | <u>0</u> | <u>10</u> |
| <u>Route 3 Box 73</u> | <u>mixed</u> | <u>10</u> | <u>41</u> |
| <u>Biloxi, Miss.</u> | <u>clay</u> | <u>41</u> | <u>64</u> |
| (mailing address) | <u>mixed</u> | <u>64</u> | <u>130</u> |
| WELL LOCATION: | <u>clay</u> | <u>130</u> | <u>152</u> |
| sec. <u>8</u> T. <u>7</u> N. R. <u>9</u> E | <u>soft clay</u> | <u>152</u> | <u>174</u> |
| S W | <u>clay</u> | <u>174</u> | <u>273</u> |
| <u>8</u> miles <u>NW</u> of <u>BILOXI</u> | <u>sand</u> | <u>273</u> | <u>278</u> |
| (distance) (direction) (nearest town) | <u>fair sand</u> | <u>278</u> | <u>298</u> |
| WELL PURPOSE: <u>Home</u> | <u>clay</u> | <u>298</u> | <u>393</u> |
| (home, irrigation, municipal, industrial) | <u>mixed</u> | <u>393</u> | <u>415</u> |
| WELL COMPLETION DATA: | <u>clay</u> | <u>415</u> | <u>451</u> |
| (1) diameter (inches) <u>2 x 4</u> | <u>sand</u> | <u>451</u> | <u>468</u> |
| (2) total depth (feet) <u>1186</u> | <u>clay</u> | <u>468</u> | <u>478</u> |
| (3) static water level (feet) <u>23</u> above top of ground. | <u>mixed</u> | <u>478</u> | <u>501</u> |
| (4) casing <u>gal. steel</u> <u>1156</u> | <u>clay</u> | <u>501</u> | <u>634</u> |
| (material) (depth) | <u>mixed</u> | <u>634</u> | <u>648</u> |
| <u>2 x 4</u> if telescope see back. | <u>sand</u> | <u>648</u> | <u>664</u> |
| (size) <u>20'</u> <u>1166'</u> | <u>clay</u> | <u>664</u> | <u>717</u> |
| (5) screen <u>10'</u> <u>1156'</u> | <u>fine sand</u> | <u>717</u> | <u>739</u> |
| <u>8ga</u> (length) (depth to top) | <u>sand</u> | <u>739</u> | <u>764</u> |
| <u>10ga</u> , <u>SS</u> on pipe | <u>fair sand</u> | <u>764</u> | <u>800</u> |
| (size) (material) | <u>hard sand</u> | <u>800</u> | <u>865</u> |
| (6) pump <u>not installed</u> | <u>sand</u> | <u>865</u> | <u>879</u> |
| (HP) (yield gpm) | <u>clay</u> | <u>879</u> | <u>909</u> |
| (type power) | <u>mixed</u> | <u>909</u> | <u>930</u> |
| (7) electric log <u>no</u> | <u>clay</u> | <u>930</u> | <u>992</u> |
| (yes or no) | <u>soft clay</u> | <u>992</u> | <u>1035</u> |
| (organization running log) | <u>mixed</u> | <u>1035</u> | <u>1057</u> |
| (8) how well bottom plugged <u>Back</u> | <u>clay</u> | <u>1057</u> | <u>1079</u> |
| <u>pressure valve</u> | <u>clay</u> | <u>1079</u> | <u>1117</u> |
| DRILLERS REMARKS: | <u>mixed</u> | <u>1117</u> | <u>1137</u> |
| | <u>sand</u> | <u>1137</u> | <u>1157</u> |
| | <u>soft clay</u> | <u>1157</u> | <u>1186</u> |

CODED

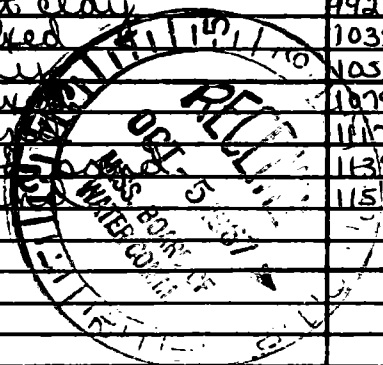

If well telescopes please sketch and show depths.

GROUND LEVEL

| | | | |
|--|--|--|---|
| | | | |
| | | | |
| | | | |
| | | | X |

SECTION 8

Please indicate well location X.

ADDITIONAL INFORMATION

If more than one screen, show locations of each on sketch.