

Harrison
M 227
8-67

MISSISSIPPI
BOARD OF WATER COMMISSIONER
416 North State Street
Jackson, Mississippi 39201

CODED

WATER WELL DRILLERS LOG

August 1967 M&B Drilling Co. Harrison
date well completed firm name county well located

LANDOWNER: Buddy J. Bley
Woolmarket - Shorecrest Rd.
R.R. - Biloxi, Miss
(mailing address)


WELL LOCATION:
sec. 9 T. 7 R. 10 S. 5 W. Woolmarket
1 miles (distance) 5 (direction) of (nearest town)

WELL PURPOSE: Home
(home, irrigation, municipal, industrial)

WELL COMPLETION DATA:
(1) diameter (inches) 4x2
(2) total depth (feet) 347
(3) static water level (feet) 37 below above top of ground.
(4) casing PVC 337 (material) (depth) 4x2 (size) if telescope see back.
(5) screen 10ft 337 (length) (depth to top) 2" PVC Sand Pac (size) (material)
(6) pump 1/2 Subm. - 20 (HP) (yield gpm) 220 V 10 (type power)
(7) electric log No (yes or no) Submersible - Bedon (organization running log)
(8) how well bottom plugged PVC Cap

description of formations encountered	from	to
Surface	0	8
White Sand	8	13
Grey Clay	13	30
White & Brown Clay	30	35
Brown & White Sand & Gravel	35	47
Grey Clay	47	50
Grey Sand & Clay	50	60
White Clay, Yellow & Grey Clay	60	85
Sand	85	90
Blue Clay	90	236
Fine Grey Sand	236	250
Blue Clay	250	266
Grey Sand	266	269
Blue Clay	269	320
Fine Sand	320	350
Blue Clay	350	+

CODED

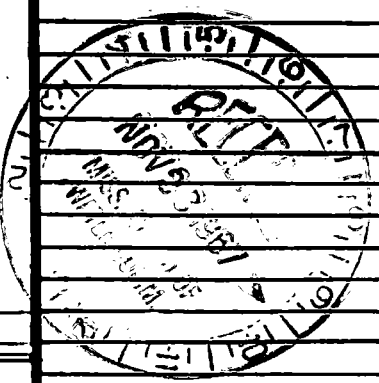

DRILLERS REMARKS:
Pump set 80 FT.

If well telescopes please sketch and show depths.


GROUND LEVEL

4" PVC
100 FT

100

2" PVC

337 10 FT
PVC Sandpac
347 Screen

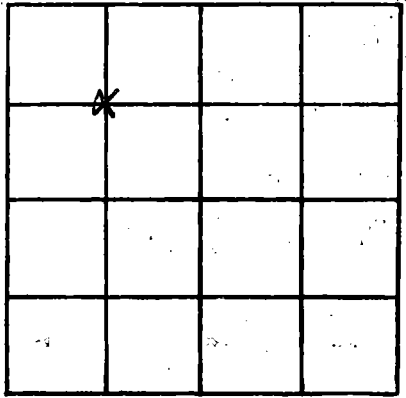

SECTION 9

Please indicate well location X.

ADDITIONAL INFORMATION

If more than one screen, show locations of each on sketch.