

Harrison
M 228
8-67

MISSISSIPPI
 BOARD OF WATER COMMISSIONERS
 416 North State Street
 Jackson, Mississippi 39201
 WATER WELL DRILLERS LOG

CODED

8/28 1967 Switzer Well Co. Harrison
 date well completed firm name county well located

LANDOWNER: Jack Briggs
Delouis Road
Miss. City, Miss.
 (mailing address)

WELL LOCATION:
 sec. 32 T 7 S R 10 E
8 miles GULFPORT of (nearest town)
 (distance) (direction)


WELL PURPOSE: APARTMENTS
 (home, irrigation, municipal, industrial)

WELL COMPLETION DATA:

- (1) diameter (inches) 3x4
- (2) total depth (feet) 683
- (3) static water level (feet) 25 below top of ground.
- (4) casing gal steel 641'
 (material) (depth)
3x4 If telescope see back.
 (size)
- (5) screen 42', 641'
 (length) (depth to top)
10ga, SS on pipe
 (size) (material)
- (6) pump 5 (HP) 75 (yield gpm)
electric
 (type power)
- (7) electric log no
 (yes or no)
 (organization running log)
- (8) how well bottom plugged Back
pressure valve

description of formations encountered	from	to
sand	0	81
clay	81	106
clay + sand streaks	106	147
fine sand	147	167
clay	167	188
clay + sand streaks	188	207
fine sand	207	228
sand	228	236
clay	236	246
clay + sand streaks	246	269
clay	269	320
sand	320	330
clay + sand streaks	330	352
fine sand	352	392
clay + sand streaks	392	474
fine sand	474	494
good sand	494	504
clay	504	520
sand	520	545
clay	545	593
sand	593	595
good sand	595	689

CODED

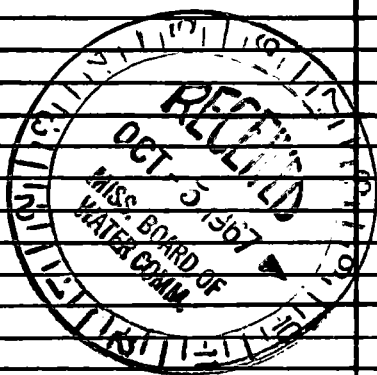

DRILLERS REMARKS:

