

Harrison
M 231
9-67

MISSISSIPPI
 BOARD OF WATER COMMISSIONERS
 416 North State Street
 Jackson, Mississippi 39201

CODED

WATER WELL DRILLERS LOG

date well completed 9/18 1967 Switzer Well Co. firm name Harrison county well located

LANDOWNER: Douglas Allen
Box 127 Pass Road
Biloxi, Miss. 39531
 (mailing address)

WELL LOCATION:
 sec. 27 T 7 A R 10 @
 S W
0.8 miles (distance) of W (direction) of TRAILER COURT (nearest town)

WELL PURPOSE: Home
 (home, irrigation, municipal, industrial)

WELL COMPLETION DATA:


- (1) diameter (inches) 3x4
- (2) total depth (feet) 436
- (3) static water level (feet) 25 below top of ground.
- (4) casing gal. steel (material) 415' (depth)
- 3x4 (size) If telescope see back.
- (5) screen 21' (length) 415' (depth to top)
- 800 (size) SS on pipe (material)
- (6) pump 1 (HP) 25 (yield gpm)
- electric (type power)
- (7) electric log No (yes or no)

(organization running log)

(8) how well bottom plugged Back pressure valve

description of formations encountered	from	to
clay	0	4
sand	4	22
sand + clay streaks	22	84
good sand	84	105
clay	105	208
sand + clay streaks	208	288
clay	288	298
fine sand	298	309
lsand	309	314
clay	314	343
sand	343	361
shells	361	380
sand + clay streaks	380	409
sand	409	422
clay	422	425
good sand	425	434

CODED

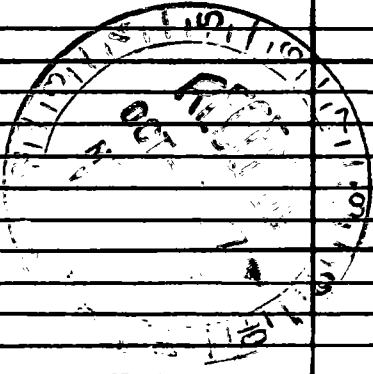

DRILLERS REMARKS:

If well telescopes please sketch and show depths.

GROUND LEVEL

X			

SECTION 27

Please indicate well location X.

ADDITIONAL INFORMATION

If more than one screen, show locations of each on sketch.