

Harrison
M 232
9-67

MISSISSIPPI
 BOARD OF WATER COMMISSIONERS
 416 North State Street
 Jackson, Mississippi 39201

CODED

WATER WELL DRILLERS LOG

9-12 1967 Sutter Well Works Harrison
 date well completed firm name county well located

LANDOWNER: Floral Gardens
Cometary Assn.
Box 1009

description of formations encountered

from to

Gulfport Miss.
 (mailing address)

Clay	0	12
Sand & gravel	12	130
Clay	130	210
sand	214	230
Clay	230	256
sand	256	274
Clay	274	325
sand	325	360
Clay	360	427
sand	427	434
Clay	434	695
sand	695	758

WELL LOCATION:

sec. 30 T. 7 S. R. 10 E. W.
 (distance) miles (direction) of Henderson (nearest town)

WELL PURPOSE: home
 (home, irrigation, municipal, industrial)

WELL COMPLETION DATA:


- (1) diameter (inches) 2 1/2 x 4
- (2) total depth (feet) 758
- (3) static water level (feet) 4 below top of ground.
- (4) casing Hel Steel 738'
 (material) (depth)
4 x 2 1/2" if telescope see back.
 (size)
- (5) screen 20' (length) 738' (depth to top)
2 1/2" (size) stainless steel (material)
- (6) pump 2 (HP) 40 (yield gpm)
elec (type power)
- (7) electric log no (yes or no)

CODED

(organization running log)

(8) how well bottom plugged BP Valve

DRILLERS REMARKS:

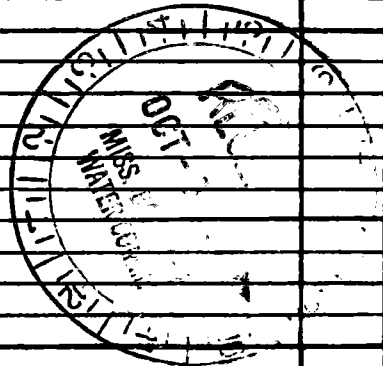

If well telescopes please sketch and show depths.

GROUND LEVEL

105' of 4"

633' of 2 1/2"

20' of 2 1/2"
Stainless Screen

X			

SECTION 30

Please indicate well location X.

ADDITIONAL INFORMATION

If more than one screen,
show locations of each on sketch.