

Harrison  
 M 233  
 9-67

MISSISSIPPI  
 BOARD OF WATER COMMISSIONERS  
 416 North State Street  
 Jackson, Mississippi 39201

**CODED**


WATER WELL DRILLERS LOG

Sept. 5 1967 M & B Drilling Co. Harrison  
 date well completed firm name county well located

LANDOWNER: <u>Hull Ward Stone</u>	description of formations encountered	from	to	
( <u>Forrest Park (pts)</u> ) <u>Back Bay</u> <u>Coastline Rd, Ocean Springs</u> (mailing address)				
<b>WELL LOCATION:</b> sec <u>22</u> T <u>7</u> S R <u>10</u> W <u>1</u> miles <u>N</u> of <u>Edgeland Park</u> (distance) (direction) (nearest town)	Surface Sand	0	15	
	Light Blue Clay	15	25	
	Coarse Sand & Wood	25	64	
	Blue Clay	64	100	
	Sand & Clay Breaks	100	120	
	Blue Clay	120	150	
	Sand	150	155	
	Soft Dark Grey Clay	155	180	
	Sand	180	187	
	Soft Dark Grey Clay	187	220	
<b>WELL PURPOSE:</b> <u>Water</u> (home, irrigation, municipal, industrial)	Grey Clay & Fibre	220	250	
	Sand	250	260	
	Grey Clay	260	310	
	Sand	310	323	
	Blue Clay	323	390	
	Sand - bk	390	408	
	Blue Clay	408	430	
	Sand & Clay Breaks	430	450	
	Blue Clay	450	525	
	Sand - Fine	525	535	
<b>WELL COMPLETION DATA:</b>	Clay	535	540	
	Fine Sand	540	575	
	Good Sand	575	650	
	Blue Clay	640	650	
(1) diameter (inches) <u>6x4</u>				
(2) total depth (feet) <u>650</u>				
(3) static water level (feet) <u>12</u> below top of ground.				
(4) casing <u>Steel</u> ( <u>580</u> ) (material) ( <u>580</u> ) (depth)				
<u>6x4</u> (size) if telescope see back.				
(5) screen <u>50</u> ( <u>580</u> ) (length) (depth to top)				
<u>40 FT 4" S. Steel, 0.002, 0.012</u> (size) (material)				
(6) pump <u>5</u> ( <u>100</u> ) (HP) (yield gpm)				
<u>260 gallon Tank</u> (type power) <u>220 Volt 1 φ</u> (type power) <u>300 gpm with 1/2 in Pumped</u>				
(7) electric log <u>No</u> (yes or no)				
<u>No</u> (organization running log)				
(8) how well bottom plugged <u>3" Back Wood Valve</u>				
<b>DRILLERS REMARKS:</b> <u>Motor - 3 φ with Phase Converter</u>				

**CODED**

Old well still used & set at 409 FT

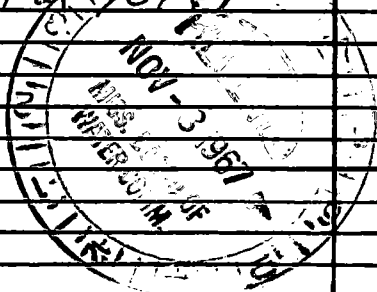

If well telescopes please sketch and show depths.

GROUND LEVEL

106 FT

6"

Steel  
Black

97-8X4  
Lead Seal

106

4"

Steel  
Black

580

40 FT

4" S.S. Screen

630

10 FT 3/4 S.S. Screen

630

20 FT

3" Tail Pipe

620

X			

SECTION 22

Please indicate well location X.

ADDITIONAL INFORMATION

Top 20 FT - 0/10

Screen Lower 20 FT - 0/2

Screen 100%

If more than one screen, show locations of each on sketch.