

Harrison  
M 234  
9-67

MISSISSIPPI  
 BOARD OF WATER COMMISSIONERS  
 416 North State Street  
 Jackson, Mississippi 39201

**CODED**

WATER WELL DRILLERS LOG

September 18 1967 R.J. Moore Harrison  
 date well completed firm name county well located

LANDOWNER:  
Albert R. Hallford Jr.  
P.O. Box 641 Biloxi Miss.  
 (mailing address)

WELL LOCATION:  
 sec. 3 T. 7 N R. 10 E  
10 miles NORTH of Biloxi, Miss.  
 (distance) (direction) (nearest town)


WELL PURPOSE: Home  
 (home, irrigation, municipal, industrial)

WELL COMPLETION DATA:

- (1) diameter (inches) 2"
- (2) total depth (feet) 325"
- (3) static water level (feet) 15' below above top of ground.
- (4) casing galv 2" 315'  
 (material) (depth)  
 \_\_\_\_\_ if telescope see back.  
 (size)
- (5) screen 10' 315'  
 (length) (depth to top)  
2" Bronze  
 (size) (material)
- (6) pump 1 15  
 (HP) (yield gpm)  
Electric  
 (type power)
- (7) electric log NO  
 (yes or no)  
 \_\_\_\_\_  
 (organization running log)
- (8) how well bottom plugged back  
wash valve

description of formations encountered	from	to
Top Soil	0	10
Red Clay	10	20
Blue Clay	20	35
Silty Sand	35	51
Blue Clay	51	93
Silty Sand	93	113
Blue Clay	113	133
Silty Sand	133	135
Blue Clay	135	219
Silty Sand	219	235
Blue Clay	235	251
Silty Sand & Clay	251	256
Blue Clay	256	289
Blue Coarse Sand	289	325


**CODED**

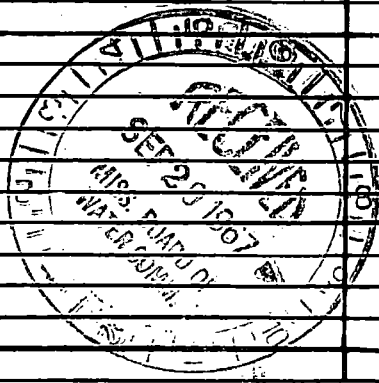

DRILLERS REMARKS: Excellent  
sand with high rate  
of return to pumping  
level

If well telescopes please sketch and show depths.

GROUND LEVEL

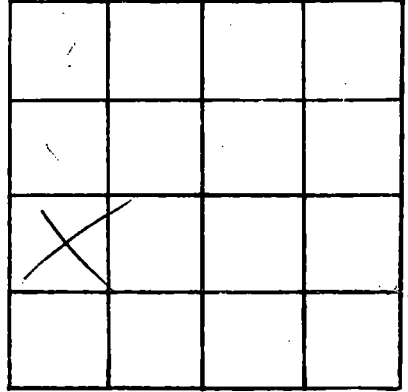

SECTION 3

Please indicate well location X.

ADDITIONAL INFORMATION

219' to 235' sand  
was tested and  
is too fine for  
a #8 strainer to  
hold.

If more than one screen,  
show locations of each on sketch.