

Harrison  
M 235  
9-67

MISSISSIPPI  
 BOARD OF WATER COMMISSIONERS  
 416 North State Street  
 Jackson, Mississippi 39201

**CODED**

WATER WELL DRILLERS LOG

September 15 1967 R.J. Moore HARRISON  
 date well completed firm name county well located

LANDOWNER: ORIN W. HUSLEY, JR

RT 1. Box 643

Biloxi, Miss.  
 (mailing address)

WELL LOCATION:

sec. 4 T. 7 N. R. 10 E.  
 (S) (W)  
10 miles N.E. of GULFPORT  
 (distance) (direction) (nearest town)

WELL PURPOSE: HOME  
 (home, irrigation, municipal, industrial)

WELL COMPLETION DATA:

- (1) diameter (inches) 2"  
 (2) total depth (feet) 324'  
 (3) static water level (feet) 15' below above top of ground.  
 (4) casing galv 2" 314'  
 (material) (depth)

         if telescope see back.  
 (size)

- (5) screen 10' 314'  
 (length) (depth to top)  
2" Stainless Steel  
 (size) (material)

- (6) pump 1 15  
 (HP) (yield gpm)  
Electric  
 (type power)

- (7) electric log NO  
 (yes or no)

          
 (organization running log)

- (8) how well bottom plugged back  
wash valve

description of formations encountered

from to

Top soil	0	10
Red Clay	10	20
Blue Clay	20	35
Silty Sand	35	50
Blue Clay	50	94
Silty Sand	94	115
Blue Clay	115	133
Silty Sand	133	135
Blue Clay	135	219
Silty Sand	219	235
Blue Clay	235	251
Silty Sand & Clay MIX	251	258
Blue Clay	258	301
Blue Coarse Sand	301	324


**CODED**



DRILLERS REMARKS: Excellent  
Spud with high rate  
of return on pumping  
level

If well telescopes please sketch and show depths.

GROUND LEVEL

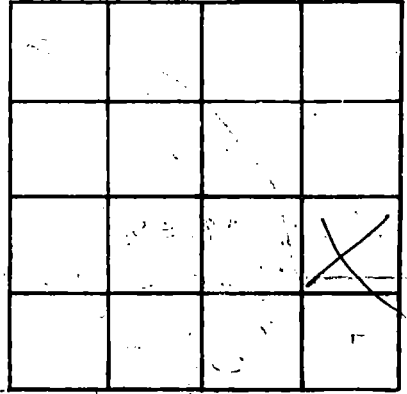

SECTION 4

Please indicate well location X.

ADDITIONAL INFORMATION

Lined area for additional information.

If more than one screen, show locations of each on sketch.