

Kamey Bridge Rd.  
next to Radio Tower

Harrison
M 234
9-67

MISSISSIPPI  
BOARD OF WATER COMMISSIONERS  
416 North State Street  
Jackson, Mississippi 39201

**CODED**

WATER WELL DRILLERS LOG

9-18 1967 date well completed  
Switzer Well Co. firm name  
Harrison county well located

LANDOWNER: James Pack  
Route 2 Box 347A  
Biloxi, Mississippi  
(mailing address)

WELL LOCATION:  
sec. 9 T. 7 S. R. 9 W.  
4 miles N of BILOXI  
(distance) (direction) (nearest town)

WELL PURPOSE: Home  
(home, irrigation, municipal, industrial)

WELL COMPLETION DATA:


- (1) diameter (inches) 2
- (2) total depth (feet) 742
- (3) static water level (feet) 0 below top of ground.
- (4) casing gal steel 732'  
(material) (depth)  
2" If telescope see back.  
(size)
- (5) screen 10' 732'  
(length) (depth to top)  
8 ga. ss on pipe  
(size) (material)
- (6) pump 1/2 8.5  
(HP) (yield gpm)  
electric  
(type power)
- (7) electric log No  
(yes or no)

(organization running log)

(8) how well bottom plugged Back pressure valve

description of formations encountered	from	to
clay	0	20
sand	20	36
clay	36	55
sand	55	60
fine sand	60	80
clay	80	100
real good sand	100	120
sand	120	125
clay	125	195
fine sand	195	213
clay	213	250
good sand	250	276
clay	276	466
sand streaks	466	481
clay	481	497
sand	497	502
mixed	502	512
clay	512	587
mixed	587	597
clay	597	619
fine sand	619	632
clay	632	649
sand	649	656
mixed	656	678
clay	678	690
fine sand	690	698
good sand	698	742

**CODED**

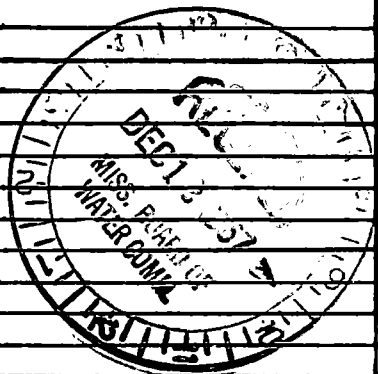

DRILLERS REMARKS:

