

MISSISSIPPI
BOARD OF WATER COMMISSIONERS
416 North State Street
Jackson, Mississippi 39201

CODED

WATER WELL DRILLERS LOG

Harrison
M 237
9-67

date well completed 9-30 1967 firm name Switzer Well Co. county well located Harrison

LANDOWNER: Doyle Dambrino
Lorraine Road - second
house S. Fritz Creek
(mailing address)

WELL LOCATION:
sec. 7 T. 7 R. 10
S W
7 miles N of HANDSBALL
(distance) (direction) (nearest town)

WELL PURPOSE: Home
(home, irrigation, municipal, industrial)

WELL COMPLETION DATA:


- (1) diameter (inches) 2
- (2) total depth (feet) 488
- (3) static water level (feet) 1'6" above top of ground.
- (4) casing gal. steel 478'
(material) (depth)
2"
(size) If telescope see back.
- (5) screen 10' 478'
(length) (depth to top)
8ga SS on pipe
(size) (material)
- (6) pump not installed
(HP) (yield gpm)

(type power)
- (7) electric log No
(yes or no)

(organization running log)
- (8) how well bottom plugged Back
pressure valve

| description of formations encountered | from | to |
|---------------------------------------|------|-----|
| clay | 0 | 10 |
| sand | 10 | 32 |
| clay | 32 | 45 |
| mixed | 45 | 60 |
| clay | 60 | 127 |
| sand | 127 | 197 |
| mixed | 197 | 207 |
| clay | 207 | 244 |
| sand | 244 | 249 |
| clay | 249 | 334 |
| mixed | 334 | 353 |
| clay | 353 | 385 |
| sand | 385 | 390 |
| clay | 390 | 419 |
| mixed | 419 | 450 |
| sand | 450 | 488 |


CODED

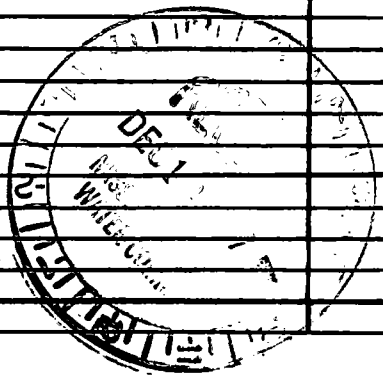

DRILLERS REMARKS:

If well telescopes please sketch and show depths.

GROUND LEVEL

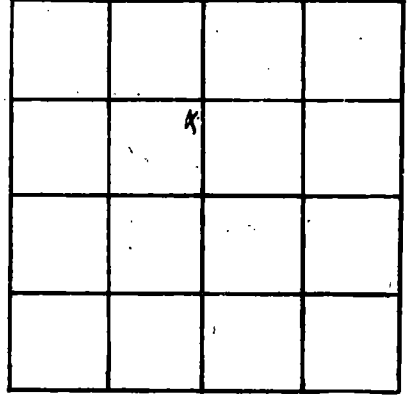

SECTION 7

Please indicate well location X.

ADDITIONAL INFORMATION

If more than one screen,
show locations of each on sketch.