

Harrison
M 238
9-67

MISSISSIPPI
BOARD OF WATER COMMISSIONERS
416 North State Street
Jackson, Mississippi 39201

CODED

WATER WELL DRILLERS LOG

9-20 1967 date well completed
Switzer Well Co. firm name
Harrison county well located

LANDOWNER: Nesley Winterstein
Hay Rd. 1/2 mile E. of
Highway 67 - Biloxi, Miss.
(mailing address)

WELL LOCATION:
sec. 8 T. 7 N. R. 9 W.
5 miles N of Biloxi
(distance) (direction) (nearest town)

WELL PURPOSE: Home
(home, irrigation, municipal, industrial)

WELL COMPLETION DATA:


- (1) diameter (inches) 2
- (2) total depth (feet) 339
- (3) static water level (feet) 28 below above
top of ground.
- (4) casing gal steel, 339'
(material) (depth)
2"
(size) if telescope see back.
- (5) screen 10', 329'
(length) (depth to top)
8 gpm, 55 gpm
(size) (material)
- (6) pump not installed
(HP) (yield gpm)

(type power)
- (7) electric log No
(yes or no)

(organization running log)
- (8) how well bottom plugged Back
pressure valve

description of formations encountered	from	to
clay + sand strks	0	22
sand	22	37
gravel	37	46
clay	46	100
fine sand	100	102
sand	102	104
clay	104	121
clay + sand strks	121	183
clay	183	204
clay + sand strks	204	225
clay	225	246
clay + sand strks	246	310
fair sand	310	330
good sand	330	339

CODED

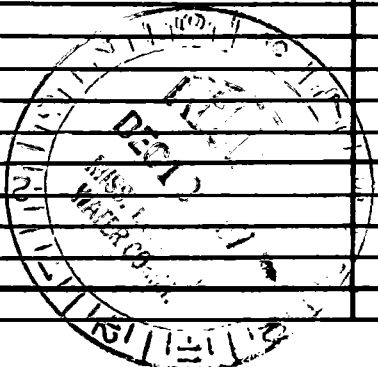

DRILLERS REMARKS:

If well telescopes please sketch and show depths.

GROUND LEVEL

			X

SECTION 8

Please indicate well location X.

ADDITIONAL INFORMATION

If more than one screen, show locations of each on sketch.