

Harrison
M 242
10-67

MISSISSIPPI
 BOARD OF WATER COMMISSIONERS
 416 North State Street
 Jackson, Mississippi 39201


CODED

WATER WELL DRILLERS LOG

10-30-1967 date well completed Switzer Well Co. firm name Harrison county well located


LANDOWNER:	description of formations encountered	from	to
<u>Ben Lamey</u>	<u>clay</u>	<u>0</u>	<u>10</u>
<u>Cedar Lake Road</u>	<u>sand</u>	<u>10</u>	<u>32</u>
<u>Biloxi, Miss.</u>	<u>clay</u>	<u>32</u>	<u>52</u>
(mailing address)	<u>sand</u>	<u>52</u>	<u>57</u>
WELL LOCATION:	<u>clay</u>	<u>57</u>	<u>87</u>
sec. <u>1</u> T. <u>7</u> S. R. <u>10</u> E. W.	<u>mixed</u>	<u>87</u>	<u>129</u>
<u>7</u> miles <u>NW</u> of <u>Biloxi</u>	<u>clay</u>	<u>129</u>	<u>288</u>
(distance) (direction) (nearest town)	<u>mixed</u>	<u>288</u>	<u>320</u>
WELL PURPOSE: <u>Home</u>	<u>sand</u>	<u>320</u>	<u>334</u>
(home, irrigation, municipal, industrial)	<u>mixed</u>	<u>334</u>	<u>356</u>
WELL COMPLETION DATA:	<u>fine sand</u>	<u>356</u>	<u>361</u>
(1) diameter (inches) <u>3x2</u>	<u>clay</u>	<u>361</u>	<u>377</u>
(2) total depth (feet) <u>490</u>	<u>fine sand</u>	<u>377</u>	<u>399</u>
(3) static water level (feet) <u>14'6"</u> above top of ground.	<u>sand</u>	<u>399</u>	<u>444</u>
(4) casing <u>gal. steel, 470'</u> (material) (depth)	<u>good sand</u>	<u>444</u>	<u>490</u>
<u>3x2</u> (size) if telescope see back.			
(5) screen <u>20'</u> (length) <u>470'</u> (depth to top)			
<u>8 ga. SS on pipe</u> (size) (material)			
(6) pump <u>3/4</u> (HP) (yield gpm)			
<u>electric</u> (type power)			
(7) electric log <u>No</u> (yes or no)			
(organization running log)			
(8) how well bottom plugged <u>Back pressure valve</u>			
DRILLERS REMARKS:			

CODED

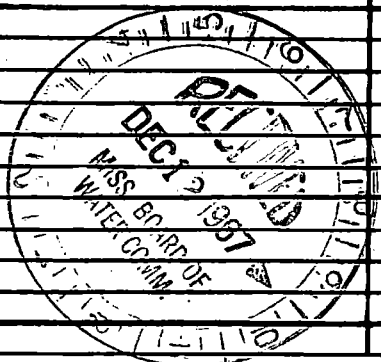

If well telescopes please sketch and show depths.

GROUND LEVEL

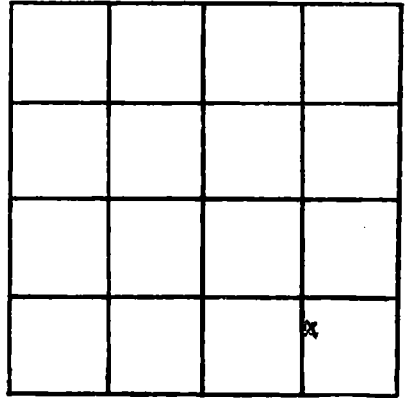

SECTION 1

Please indicate well location X.

ADDITIONAL INFORMATION

If more than one screen, show locations of each on sketch.