

Harrison
 M243
 10-67

MISSISSIPPI
 BOARD OF WATER COMMISSIONERS
 416 North State Street
 Jackson, Mississippi 39201


CODED

WATER WELL DRILLERS LOG

10-7 1967 Switzer Shell Co. Harrison
 date well completed firm name county well located


LANDOWNER:	description of formations encountered	from	to
<u>D. J. Heraci</u>	clay	0	15
<u>1/4 mi. off Hwy Road</u>	sand	15	22
<u>Biloxi, Miss.</u>	sand + gravel	22	44
(mailing address)	mixed	44	54
WELL LOCATION:	clay	54	65
sec. <u>7</u> T. <u>7</u> R. <u>9</u>	mixed	65	87
<u>4</u> miles <u>NW</u> of <u>BILOXI</u>	clay	87	111
(distance) (direction) (nearest town)	sand	111	155
WELL PURPOSE:	mixed	155	178
(home, irrigation, municipal, industrial)	clay	178	332
WELL COMPLETION DATA:	mixed	332	355
(1) diameter (inches) <u>2</u>	sand	355	360
(2) total depth (feet) <u>778</u>	clay	360	377
(3) static water level (feet) <u>7'</u> below top of ground.	clay + shale	377	399
(4) casing <u>gal. steel 768'</u> (material) (depth)	sand	399	404
<u>2"</u> (size) If telescope see back.	clay	404	487
(5) screen <u>10'</u> (length) <u>768'</u> (depth to top)	mixed	487	519
<u>10ga. SS on pipe</u> (size) (material)	sand	519	531
(6) pump <u>1/2</u> (HP) <u>8.5</u> (yield gpm)	clay	531	725
<u>electric</u> (type power)	fair sand	725	746
(7) electric log <u>No</u> (yes or no)	good sand	746	778
(8) how well bottom plugged <u>Back pressure valve</u>			
DRILLERS REMARKS:			

CODED

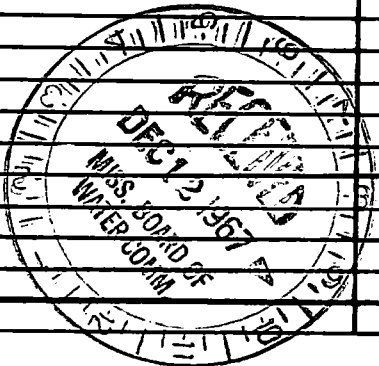

If well telescopes please sketch and show depths.

GROUND LEVEL

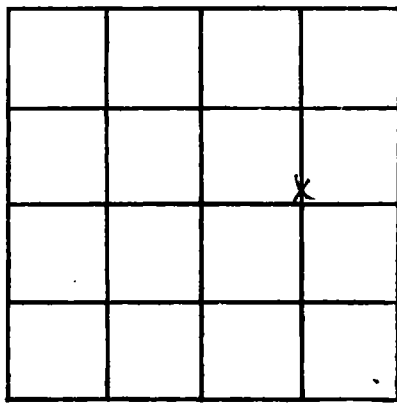

SECTION 7

Please indicate well location X.

ADDITIONAL INFORMATION

If more than one screen, show locations of each on sketch.