

Harrison
 M 244
 10-67

MISSISSIPPI
 BOARD OF WATER COMMISSIONERS
 416 North State Street
 Jackson, Mississippi 39201

CODED

WATER WELL DRILLERS LOG

10-5 1967 date well completed
 Switzer Well Co. firm name
 Harrison county well located

LANDOWNER: Jules Schwan
 Hwy Rd. next to Hwy 67
 Biloxi, Miss.
 (mailing address)

WELL LOCATION:
 sec. 8 T. 7 S. R. 9 W.
 6 miles N of BILOXI
 (distance) (direction) (nearest town)


WELL PURPOSE: Home
 (home, irrigation, municipal, industrial)

WELL COMPLETION DATA:

- (1) diameter (inches) 2
- (2) total depth (feet) 353
- (3) static water level (feet) 24 below top of ground.
- (4) casing gal steel, 243, (material) (depth)
 2" If telescope see back. (size)
- (5) screen 10', 343' (length) (depth to top)
 10ga, ss on pipe (size) (material)
- (6) pump not installed (HP) (yield gpm)
- (type power)
- (7) electric log No (yes or no)
- (organization running log)
- (8) how well bottom plugged Back pressure valve

description of formations encountered	from	to
clay	0	15
sand	15	30
gravel	30	32
clay	32	58
mixed	58	66
clay	66	124
mixed	124	158
clay	158	180
fair sand	180	195
sand	195	234
clay	234	268
mixed	268	290
clay	290	307
sand	307	352

CODED

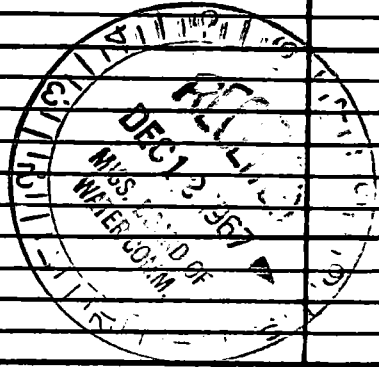

DRILLERS REMARKS:

If well telescopes please sketch and show depths.

GROUND LEVEL

		K	

SECTION 8

Please indicate well location X.

ADDITIONAL INFORMATION

If more than one screen, show locations of each on sketch.