

Harrison
 M 245
 10-67

MISSISSIPPI
 BOARD OF WATER COMMISSIONERS
 416 North State Street
 Jackson, Mississippi 39201

CODED

WATER WELL DRILLERS LOG

10-10 1967 date well completed
 Switzer Well Co. firm name
 Harrison county well located

LANDOWNER: Donald Bradley
 Goodman Road
 Biloxi, Miss
 (mailing address)

WELL LOCATION:
 sec 17 T 7 R 9 S W
 4 miles NW of BILOXI
 (distance) (direction) (nearest town)

WELL PURPOSE: Home
 (home, irrigation, municipal, industrial)


WELL COMPLETION DATA:

- (1) diameter (inches) 2
- (2) total depth (feet) 390
- (3) static water level (feet) 18 below top of ground.
- (4) casing gal. steel, 382' (material) (depth)
2" (size) If telescope see back.
- (5) screen 8' (length), 382' (depth to top)
10 ga. ss on pipe (size) (material)
- (6) pump 1/2 (HP), 8.5 (yield gpm)
electric (type power)
- (7) electric log No (yes or no)
 (organization running log)
- (8) how well bottom plugged Back pressure valve

DRILLERS REMARKS:


description of formations encountered	from	to
clay	0	48
sand	48	58
clay	58	65
clay + sand streaks	65	125
clay	125	146
clay + sand streaks	146	167
clay	167	227
clay + sand streaks	227	269
sand	269	279
clay	279	289
clay + sand streaks	289	329
clay	329	345
sand	345	350
fine sand	350	370
good sand	370	390

CODED

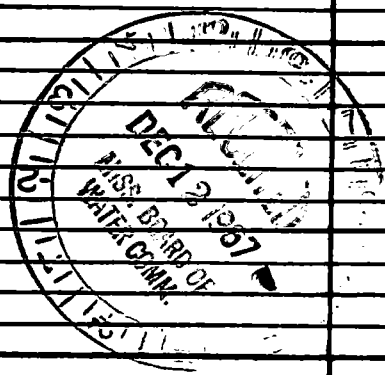

If well telescopes please sketch and show depths.

GROUND LEVEL

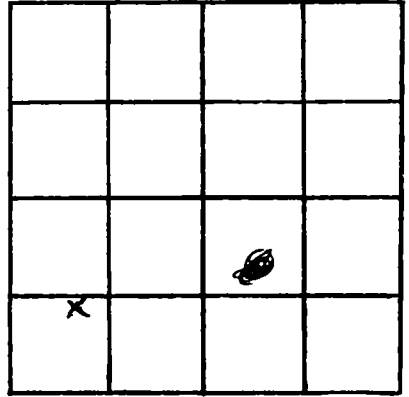

SECTION ~~17~~ 17

Please indicate well location X.

ADDITIONAL INFORMATION

If more than one screen, show locations of each on sketch.