


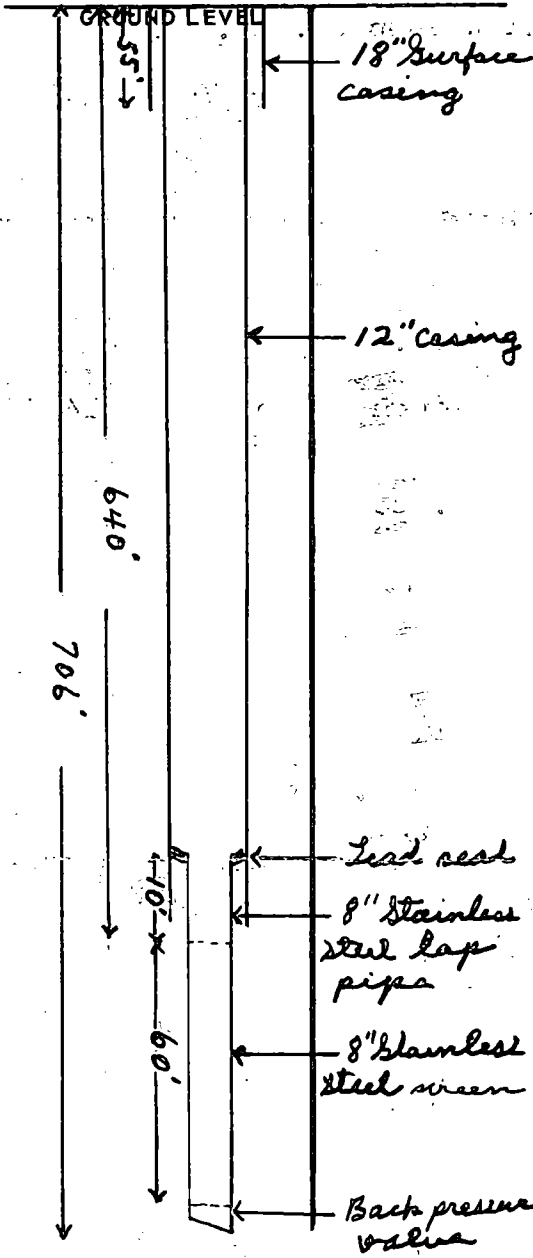

If well telescopes please sketch and show depths.



X			

SECTION 35

Please indicate well location X.

ADDITIONAL INFORMATION

55' of 18" pipe (cemented)

12" casing cemented entire length by Halliburton

One metal Stainless steel screen (Howard Smith)

Well developed to 1550 GPM

If more than one screen, show locations of each on sketch.