

Harrison
M 250
11-67

MISSISSIPPI
 BOARD OF WATER COMMISSIONERS
 416 North State Street
 Jackson, Mississippi 39201

CODED

WATER WELL DRILLERS LOG

11-30 1967 Switzer Well Co. Harrison
 date well completed firm name county well located

LANDOWNER: L.C. Capdebahn
Route 1 Box 676A
Biloxi, Miss.
 (mailing address)

WELL LOCATION:
 sec. 17 T. 7 N. R. 10 W.
S miles S of WOOLMAR
 (distance) (direction) (nearest town)

WELL PURPOSE: Home
 (home, irrigation, municipal, industrial)

WELL COMPLETION DATA:

- (1) diameter (inches) 2
- (2) total depth (feet) 514
- (3) static water level (feet) ground below top of ground.
- (4) casing gal steel, 504,
 (material) (depth)
2" if telescope see back.
 (size)
- (5) screen 20', 494'
 (length) (depth to top)
8 ga, 55 oz pipe
 (size) (material)
- (6) pump 1 25 GPM
 (HP) (yield gpm)
electric
 (type power)
- (7) electric log No
 (yes or no)


(organization running log)

(8) how well bottom plugged Back
pressure valve

DRILLERS REMARKS:


description of formations encountered	from to	
clay	0	38
sand	38	55
mixed	55	67
clay	67	114
mixed	114	136
clay	136	197
sand	197	212
clay	212	290
mixed	290	359
clay	359	380
sand	380	388
clay	388	401
mixed	401	423
clay	423	440
sand	440	514

CODED

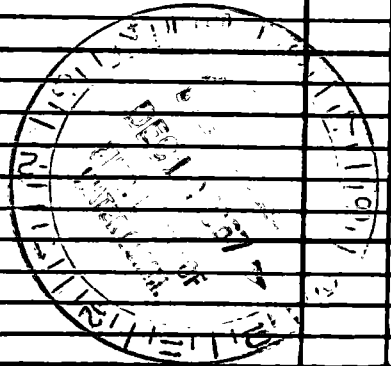

If well telescopes please sketch and show depths.

GROUND LEVEL

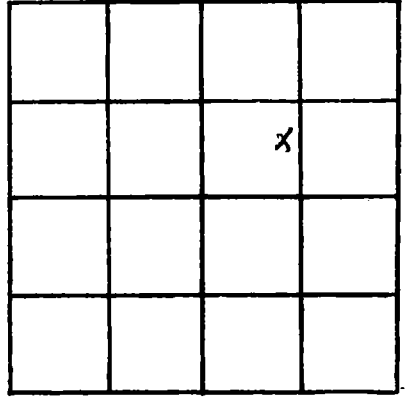

SECTION 17

Please indicate well location X.

ADDITIONAL INFORMATION

If more than one screen, show locations of each on sketch.