

Harrison  
 M 252  
 12-67

MISSISSIPPI  
 BOARD OF WATER COMMISSIONERS  
 416 North State Street  
 Jackson, Mississippi 39201

**CODED**

WATER WELL DRILLERS LOG

12-9 1967 date well completed  
 Sutter Well Works firm name  
 Harrison county well located

LANDOWNER: Gulf Coast  
 Bldg. & Supply Co.  
 Mobile, Ala.  
 (mailing address)


WELL LOCATION:  
 sec. 22 T 7 R 9 S W  
 1 miles N of Biloxi  
 (distance) (direction) (nearest town)

WELL PURPOSE: Industrial  
 (home, irrigation, municipal, industrial)

- WELL COMPLETION DATA:
- (1) diameter (inches)  $2\frac{1}{2} \times 3 \times 4$
  - (2) total depth (feet) 898
  - (3) static water level (feet) 5 <sup>below</sup> ~~above~~ top of ground.
  - (4) casing steel, 878',  
 (material) (depth)  
 $2\frac{1}{2} \times 4$   
 (size) If telescope see back.
  - (5) screen 20', 878'  
 (length) (depth to top)  
3", stainless steel  
 (size) (material)
  - (6) pump 2 40  
 (HP) (yield gpm)  
elec  
 (type power)
  - (7) electric log no  
 (yes or no)  
 (organization running log)
  - (8) how well bottom plugged B.P. Valve

description of formations encountered	from	to
Clay	0	40
sand	40	61
Clay	61	125
sand	125	210
Clay	210	517
sand	517	532
Clay	532	660
sand	660	702
Clay	702	747
fine sand	747	852
Coarse sand	852	898

**CODED**

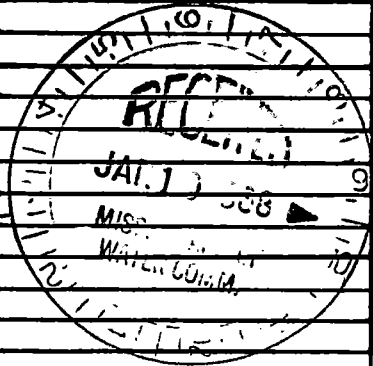

DRILLERS REMARKS:

If well telescopes please sketch and show depths.

GROUND LEVEL

84' of 4" galv. Casing

34' of 4" black Casing

760' of 2 1/2" blk Casing

3x20 SCREEN

50			
X			

SECTION 22

Please indicate well location X.

ADDITIONAL INFORMATION

If more than one screen, show locations of each on sketch.