

Harrison
M253
1-68

MISSISSIPPI
 BOARD OF WATER COMMISSIONERS
 416 North State Street
 Jackson, Mississippi 39201

CODED

WATER WELL DRILLERS LOG

JAN 9 1968 COAST WATER WELL SERVICE HARRISON
 date well completed firm name county well located

LANDOWNER: Carl C. Frisby
506 Central ave

N. Biloxi Man's
 (mailing address)

WELL LOCATION: NO Map
 sec 21 T 7 N R 2 E
1 miles N of Biloxi
 (distance) (direction) (nearest town)

WELL PURPOSE:
 (home, irrigation, municipal, industrial)

WELL COMPLETION DATA:

- (1) diameter (inches) 2"
- (2) total depth (feet) 440
- (3) static water level (feet) 21 below
 top of ground above
- (4) casing 6 GALV. 430'
 (material) (depth)
2" If telescope see back.
 (size)
- (5) screen 10# 430 ft
 (length) (depth to top)
2" STAINLESS STEEL
 (size) (material)
- (6) pump 1 10
 (HP) (yield gpm)
220 volts electric
 (type power)
- (7) electric log NO
 (yes or no)


(organization running log)

(8) how well bottom plugged 2" BACK
WASH DAVE

DRILLERS REMARKS:

description of formations encountered	from	to
RED. CLAY	0	14
FINE GRAIN SAND	14	18
WHITE + G. BLUE CLAY	18	30
MED. GRAIN SAND	30	70
BLUE CLAY (GREENISH)	70	102
FINE SAND + TOWNESOT SHALE	102	173
G. BLUE CLAY	173	418
MED. GRAIN SAND	418	440

CODED

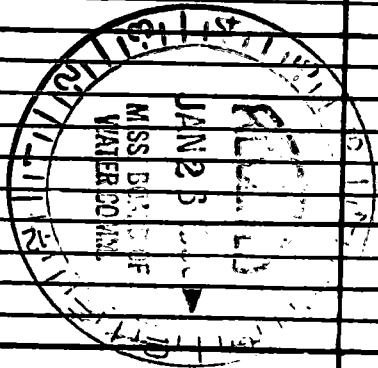

If well telescopes please sketch and show depths.

GROUND LEVEL

X			

SECTION 21

Please indicate well location X.

ADDITIONAL INFORMATION

If more than one screen, show locations of each on sketch.