

rise road 1 blk.  
Hess Debye road

Harrison  
M255  
1-68

MISSISSIPPI  
BOARD OF WATER COMMISSIONERS  
416 North State Street  
Jackson, Mississippi 39201

**CODED**

WATER WELL DRILLERS LOG

1-19 1968 date well completed     Switzer Well Co. firm name     Harrison county well located

LANDOWNER: Curt Temple  
Lernwood Village  
Jess Rd. Hardsboro  
(mailing address)

WELL LOCATION:  
29 sec 7 T 7 S     R 10 W  
6 miles E of GULFPORT  
(distance) (direction) (nearest town)


WELL PURPOSE:  
(home, irrigation, municipal, industrial)

WELL COMPLETION DATA:

- (1) diameter (inches) 8 1/2" of 4" top  
6 x 4
- (2) total depth (feet) 650
- (3) static water level (feet) 18 below top of ground.
- (4) casing gal. steel 620 (material) (depth)  
6 x 4 if telescope see back.  
(size)
- (5) screen 30' (length) 620' (depth to top)  
10 ga. ss on pipe (size) (material)
- (6) pump 5 (HP) 60 (yield gpm)  
electric (type power)
- (7) electric log No (yes or no)  
(organization running log)
- (8) how well bottom plugged Back pressure valve

description of formations encountered	from	to
logs + sand	0	28
sand	28	33
clay	33	45
mixed	45	56
sand	56	66
mixed	66	88
sand	88	96
clay	96	132
sand	132	135
clay	135	196
fine sand	196	218
brnd	218	239
clay	239	330
mixed	330	336
clay	336	556
sand	556	650

**CODED**

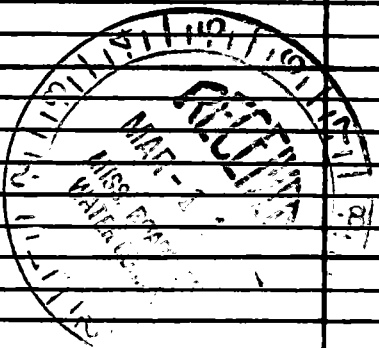

DRILLERS REMARKS:

If well telescopes please sketch and show depths.

GROUND LEVEL

			X

SECTION ~~28~~ 29

Please indicate well location X.

ADDITIONAL INFORMATION

If more than one screen,  
show locations of each on sketch.