

Harrison
 4250
 7-68

MISSISSIPPI
 BOARD OF WATER COMMISSIONERS
 416 North State Street
 Jackson, Mississippi 39201

CODED

WATER WELL DRILLERS LOG

July 3 1968 Ladner's Well Works Harrison
 date well completed firm name county well located

LANDOWNER: Mr. Lamey
Highway 67
Biloxi, Miss.
 (mailing address)

description of formations encountered	from	to
<u>Yellow Clay + Sand</u>	<u>0</u>	<u>40</u>
<u>Blue Shale + fine sand</u>	<u>40</u>	<u>240</u>
<u>Coarse blue sand</u>	<u>240</u>	<u>260</u>


WELL LOCATION:
 sec 22 T 7 N R 9 E
2 miles N of O. Shreve
 (distance) (direction) (nearest town)

WELL PURPOSE: Home
 (home, irrigation, municipal, industrial)

WELL COMPLETION DATA:

- (1) diameter (inches) 2 inch
- (2) total depth (feet) 260 ft.
- (3) static water level (feet) 6 below top of ground.
- (4) casing Galvneal 250
 (material) (depth)
2 inch (size) if telescope see back.
- (5) screen 10 ft., 250'
 (length) (depth to top)
2 in., 55
 (size) (material)
- (6) pump 1 15
 (HP) (yield gpm)
Elec.
 (type power)
- (7) electric log No
 (yes or no)
- (organization running log)
- (8) how well bottom plugged Ball Check


CODED

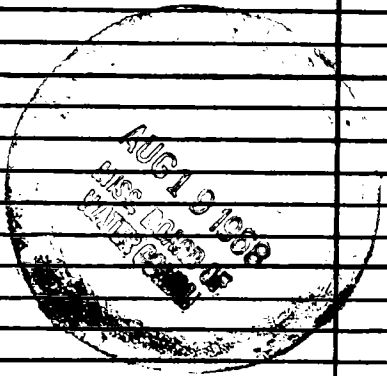

DRILLERS REMARKS:

If well telescopes please sketch and show depths.

GROUND LEVEL

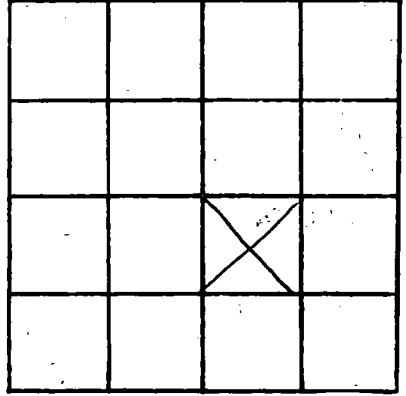

SECTION 22

Please indicate well location X.

ADDITIONAL INFORMATION

If more than one screen, show locations of each on sketch.