

1/2 mil. diameter

Harrison
M 261
2-65

MISSISSIPPI
BOARD OF WATER COMMISSIONERS
416 North State Street
Jackson, Mississippi 39201

CODED

CODED
WATER WELL DRILLERS LOG

7-15 1968 Switzer Well Co Harrison
date well completed firm name county well located

LANDOWNER: Bob Dringle

Brazier Road

Biloxi Miss
(mailing address)

WELL LOCATION:

sec. 13 T 7 S R 10 E
6 miles NW of Biloxi
(distance) (direction) (nearest town)

WELL PURPOSE: Home
(home, irrigation, municipal, industrial)

WELL COMPLETION DATA:

(1) diameter (inches) 3

(2) total depth (feet) 400

(3) static water level (feet) 22 below
top of ground.

(4) casing gal steel 380'
(material) (depth)

3"
(size) If telescope see back.

(5) screen 20', 380'
(length) (depth to top)

8ga, ss on pipe
(size) (material)

(6) pump 1 1/2 (HP) (yield gpm)

electric
(type power)

(7) electric log No
(yes or no)


(organization running log)

(8) how well bottom plugged Back
pressure valve

DRILLERS REMARKS:


description of formations encountered	from	to
clay	0	70
sand	70	95
clay	95	129
sand	129	137
mixed	137	159
sand	159	169
clay	169	291
mixed	291	311
sand	311	316
mixed	316	326
sand	326	331
fair sand	331	351
clay	351	356
sand	356	392
good sand	392	410

CODED

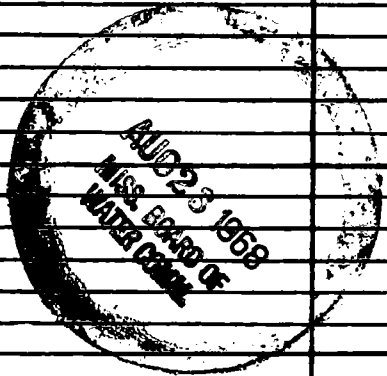

If well telescopes please sketch and show depths.

GROUND LEVEL

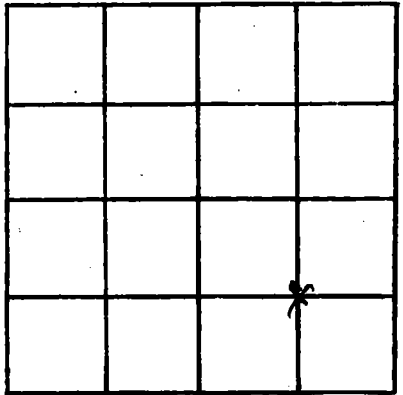

SECTION 13

Please indicate well location X.

ADDITIONAL INFORMATION

If more than one screen, show locations of each on sketch.