

MISSISSIPPI  
BOARD OF WATER COMMISSIONERS  
416 North State Street  
JACKSON, MISSISSIPPI 39201

**CODED**

WATER WELL DRILLERS LOG


Harrison  
M 262  
2-68

date well completed 2-19 1968 firm name Switzer Well Co. county well located Harrison

LANDOWNER: <u>South Central</u>	description of formations encountered	from	to
<u>Bell Telephone Company</u>			
<u>Edgewater Plaza</u>	<u>sand</u>	<u>0</u>	<u>37</u>
<u>Biloxi</u> (mailing address) <u>Miss.</u>	<u>clay</u>	<u>37</u>	<u>61</u>
WELL LOCATION:	<u>sand</u>	<u>61</u>	<u>66</u>
sec. <u>33</u> T. <u>7</u> R. <u>10</u>	<u>clay</u>	<u>66</u>	<u>113</u>
<u>S</u> miles <u>W</u> of <u>Biloxi</u>	<u>clay</u>	<u>113</u>	<u>202</u>
(distance) (direction) (nearest town)	<u>mixed</u>	<u>202</u>	<u>217</u>
WELL PURPOSE:	<u>clay</u>	<u>217</u>	<u>267</u>
(home, irrigation, municipal, industrial)	<u>mixed clay</u>	<u>267</u>	<u>289</u>
WELL COMPLETION DATA:	<u>clay</u>	<u>289</u>	<u>354</u>
(1) diameter (inches) <u>4 x 3</u>	<u>sand</u>	<u>354</u>	<u>364</u>
(2) total depth (feet) <u>622</u>	<u>clay</u>	<u>364</u>	<u>439</u>
(3) static water level (feet) <u>17'6"</u> below above top of ground.	<u>mixed</u>	<u>439</u>	<u>484</u>
(4) casing <u>gal steel, 652'</u> (material) (depth)	<u>clay</u>	<u>484</u>	<u>571</u>
<u>4 x 3</u> If telescope see back. (size)	<u>mixed</u>	<u>571</u>	<u>588</u>
(5) screen <u>20'</u> <u>652'</u> (length) (depth to top)	<u>good sand</u>	<u>588</u>	<u>683</u>
<u>10 ga.</u> <u>SS on pipe</u> (size) (material)			
(6) pump <u>1</u> <u>350 gal</u> (HP) (yield gpm)			
<u>electric</u> (type power)			
(7) electric log <u>No</u> (yes or no)			
(organization running log)			
(8) how well bottom plugged <u>Back pressure valve</u>			
DRILLERS REMARKS:			

Well set at 622'

**CODED**

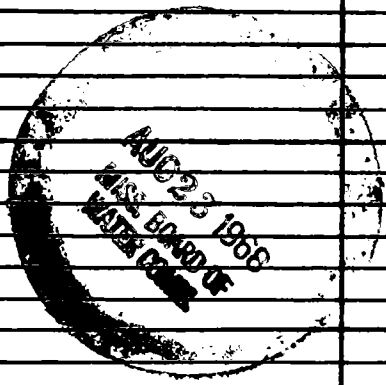

If well telescopes please sketch and show depths.

2000

GROUND LEVEL

			*

SECTION 33

Please indicate well location X.

ADDITIONAL INFORMATION

If more than one screen, show locations of each on sketch.