

one mile East  
 of Dan Lake Rd  
 in survey 57

Harrison  
M 263  
2-68

MISSISSIPPI  
 BOARD OF WATER COMMISSIONERS  
 416 North State Street  
 Jackson, Mississippi 39201

**CODED**

WATER WELL DRILLERS LOG

7-16 1968 Switzer Well Co. Harrison  
 date well completed firm name county well located

LANDOWNER Refus Broadus

description of formations encountered

Survey 57  
Biloxi Miss  
 (mailing address)

from	to
0	10
10	20
20	42
42	63

WELL LOCATION:  
 sec 6 T 7 R 9  
 S W  
61 miles N of BLOXI  
 (distance) (direction) (nearest town)

63	109
109	130
130	151
151	173
173	194

WELL PURPOSE: Home  
 (home, irrigation, municipal, industrial)


194	218
218	240
240	280

WELL COMPLETION DATA:

- (1) diameter (inches) 2
- (2) total depth (feet) 721
- (3) static water level (feet) 20 below above top of ground.
- (4) casing gal steel 701'  
 (material) (depth)  
2" If telescope see back.  
 (size)
- (5) screen 20', 701'  
 (length) (depth to top)  
8ga, 55 on pipe  
 (size) (material)
- (6) pump \_\_\_\_\_  
 (HP) (yield gpm)  
 (type power)
- (7) electric log No  
 (yes or no)  
 (organization running log)
- (8) how well bottom plugged Back pressure valve

280	284
284	295
295	306
306	329
329	616
616	626
626	642
642	722


**CODED**

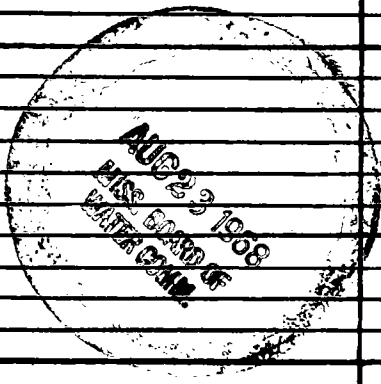

DRILLERS REMARKS:

If well telescopes please sketch and show depths.

GROUND LEVEL

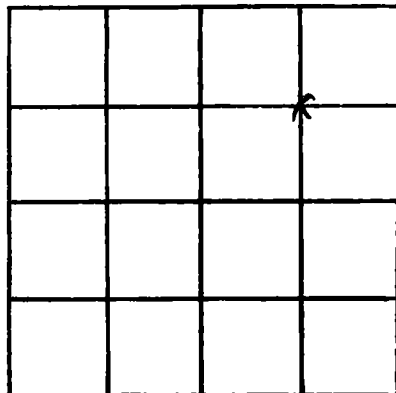

SECTION 6

Please indicate well location X.

ADDITIONAL INFORMATION

If more than one screen, show locations of each on sketch.