

Corner Beauvoir rd
& Hwy 90

Harrison
M 264
6-68

MISSISSIPPI
BOARD OF WATER COMMISSIONERS
416 North State Street
Jackson, Mississippi 39201

CODED

WATER WELL DRILLERS LOG

6-29 1968 Switzer Well Co. Harrison
date well completed firm name county well located

LANDOWNER: Mrs. Catherine Young

description of formations encountered

from to

89 Chest Beach
Biloxi, Miss.
(mailing address)

sand	0	37
clay	37	68
mixed	68	78
clay	78	90
sand	90	100
clay	100	134
mixed	134	144
clay	144	244
sand	244	252
clay	252	370
sand	370	382
clay	382	437
sand	437	485
good sand	485	486

WELL LOCATION:
sec. 34 T 7 S R 10 E
3 miles W of BILOXI
(distance) (direction) (nearest town)


WELL PURPOSE: Home
(home, irrigation, municipal, industrial)

WELL COMPLETION DATA:

- (1) diameter (inches) 2
- (2) total depth (feet) 486
- (3) static water level (feet) 19 below above top of ground.
- (4) casing gal steel 476' (material) (depth)
2" (size) If telescope see back.
- (5) screen 10' (length) 476' (depth to top)
10ga. ss on pipe (size) (material)
- (6) pump 1/2 (HP) 8.5 (yield gpm)
electric (type power)
- (7) electric log No (yes or no)
(organization running log)
- (8) how well bottom plugged Back
pressure valve


DRILLERS REMARKS:

CODED

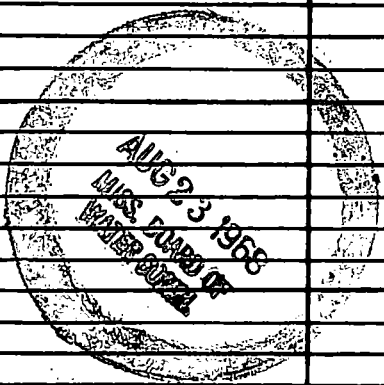

If well telescopes please sketch and show depths.

GROUND LEVEL

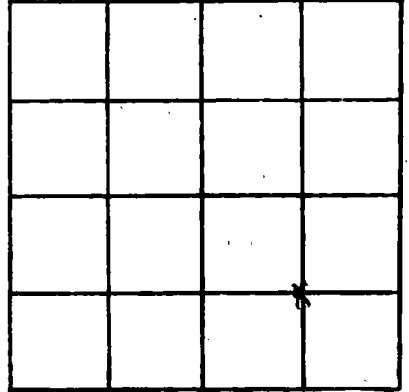

SECTION 34

Please indicate well location X.

ADDITIONAL INFORMATION

If more than one screen, show locations of each on sketch.