

Page 1 of 1
Form No. 10

MISSISSIPPI
BOARD OF WATER COMMISSIONERS
416 North State Street
Jackson, Mississippi 39201

CODED

WATER WELL DRILLERS LOG

Harrison
M 265
8-68

8-9 1968 Switzer Hall Co. Harrison
date well completed firm name county well located

LANDOWNER: Lloyd Fountain
421 Square Road
Biloxi Miss
(mailing address)

description of formations encountered	from	to
	<u>clay</u>	<u>0</u>
<u>sand</u>	<u>10</u>	<u>38</u>
<u>clay</u>	<u>38</u>	<u>63</u>
<u>good sand</u>	<u>63</u>	<u>83</u>
<u>mixed</u>	<u>83</u>	<u>125</u>
<u>fine sand</u>	<u>125</u>	<u>167</u>
<u>clay</u>	<u>167</u>	<u>182</u>
<u>sand</u>	<u>182</u>	<u>196</u>
<u>clay</u>	<u>196</u>	<u>205</u>
<u>mixed</u>	<u>205</u>	<u>226</u>
<u>fine sand</u>	<u>226</u>	<u>266</u>
<u>sand</u>	<u>266</u>	<u>274</u>

WELL LOCATION:
sec. 16 T. 7 S. R. 9 E.
3 miles N of BILOXI
(distance) (direction) (nearest town)


WELL PURPOSE: Home
(home, irrigation, municipal, industrial)

WELL COMPLETION DATA:

- (1) diameter (inches) 2
- (2) total depth (feet) 270
- (3) static water level (feet) 18' 7" below top of ground.
- (4) casing gal steel 255'
(material) (depth)
2" if telescope see back.
(size)
- (5) screen 15' 255'
(length) (depth to top)
8 ga. ss on pipe
(size) (material)
- (6) pump 1/2 2.5
(HP) (yield gpm)
electric
(type power)
- (7) electric log No
(yes or no)

(organization running log)
- (8) how well bottom plugged Back
pressure valve

CODED

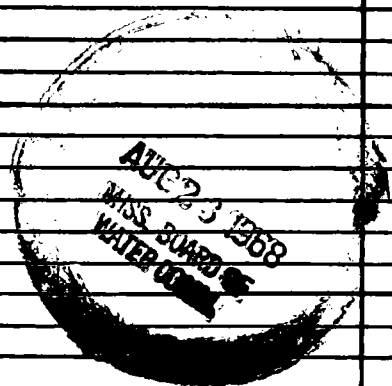

DRILLERS REMARKS:

