


If well telescopes please sketch and show depths.

GROUND LEVEL

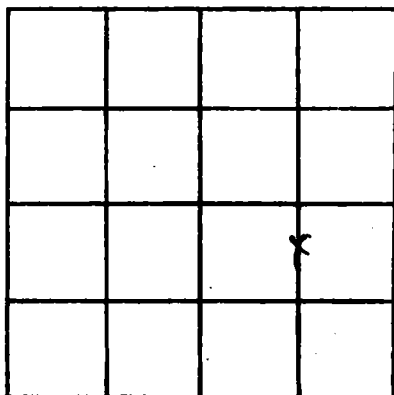

SECTION 16

Please indicate well location X.

ADDITIONAL INFORMATION

997 - 1005	sand
1005 - 1027	mixed
1027 - 1074	fine sand
1074 - 1095	mixed
1095 - 1117	fine sand
1117 - 1139	fair sand
1139 - 1220	good sand
1220 - 1241	sand gravel
1241 - 1250	gravel

If more than one screen, show locations of each on sketch.