

HARRISON
M 267
5-31-72

MISSISSIPPI
 BOARD OF WATER COMMISSIONERS
 416 North State Street
 Jackson, Mississippi 39201

CODED

WATER WELL DRILLERS LOG

5-31 19 72 Switzer Well Co. HARRISON
 date well completed firm name county well located

LANDOWNER: Thomas Wieck
Rt 6 Box 125A
Biloxi, Miss. 39532
 (mailing address)

WELL LOCATION:
 sec. 8 T. 7 S. R. 9 W.
2 miles North of Biloxi
 (distance) (direction) (nearest town)

WELL PURPOSE: home
 (home, irrigation, municipal, industrial)

WELL COMPLETION DATA:

- (1) diameter (inches) 8" 2"
- (2) total depth (feet) 400'
- (3) static water level (feet) 70' ^{below} _{above} top of ground.
- (4) casing galv. 400'
 (material) (depth)
 (size) If telescope see back.
- (5) screen 10' 390'
 (length) (depth to top)
008 stainless steel
 (size) (material)
- (6) pump 1 6.1
 (HP) (yield gpm)
Electric
 (type power)
- (7) electric log —
 (yes or no)

(organization running log)

(8) how well bottom plugged back
pressure valve

description of formations encountered	from	to
clay	0	6
sand & gravel	6	20
sand	20	30
clay	30	35
sand	35	40
mixed	40	60
sand	60	70
clay	70	160
shail + clay	160	179
soft clay	179	199
clay	199	236
sand	236	239
clay	239	242
sand	242	250
clay	250	366
fine sand	366	376
fair sand	376	400

CODED


JUN 26 1972

DRILLERS REMARKS:

MISS. DEP. OF
 WATER RESOURCES

If well telescopes please sketch and show depths.

GROUND LEVEL

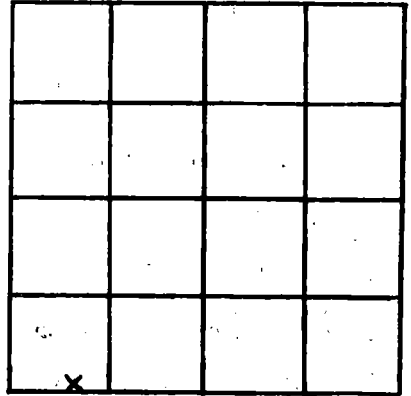

SECTION 8

Please indicate well location X.

ADDITIONAL INFORMATION

If more than one screen, show locations of each on sketch.