

**MISSISSIPPI
BOARD OF WATER COMMISSIONERS**
416 North State Street
Jackson, Mississippi 39201

CODED

WATER WELL DRILLERS LOG

Harrison
N 268
268

July 25 1968 Switzer Well Co. Harrison
date well completed firm name county well located

LANDOWNER: Arlin Richard

description of formations encountered

from to

407 Opetrack Road

clay

0 18

sand

18 42

clay

42 68

mixed

68 92

soft clay

92 114

sand

114 119

clay

119 131

sand

131 136

mixed

136 158

soft clay

158 180

mixed

180 202

clay

202 265

sand

265 300

Beloxi Miss.
(mailing address)

WELL LOCATION:

sec. 21 T. 7 S. R. 9 E.
2 miles N of BLOXI
(distance) (direction) (nearest town)

WELL PURPOSE: Home
(home, irrigation, municipal, industrial)

WELL COMPLETION DATA:

- (1) diameter (inches) 2"
(2) total depth (feet) 300'
(3) static water level (feet) 21 below above top of ground.

(4) casing gal steel 290'
(material) (depth)
2"
(size) If telescope see back.

(5) screen 10' 290'
(length) (depth to top)
8 ga. SS on pipe
(size) (material)

(6) pump not installed
(HP) (yield gpm)

(type power)


(7) electric log No
(yes or no)

(organization running log)

(8) how well bottom plugged Back pressure valve

DRILLERS REMARKS:

CODED

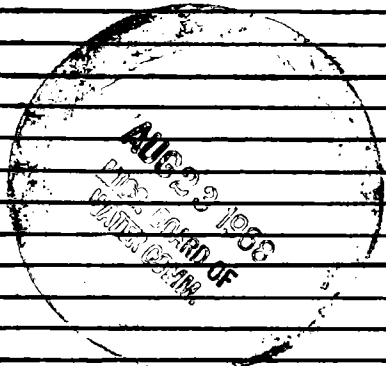

If well telescopes please sketch and show depths.

GROUND LEVEL

		X	

SECTION 21

Please indicate well location X.

ADDITIONAL INFORMATION

If more than one screen, show locations of each on sketch.