

One block off
Racetrack Road

Harrison
M 269
6-68

MISSISSIPPI
BOARD OF WATER COMMISSIONERS
416 North State Street
Jackson, Mississippi 39201

CODED

WATER WELL DRILLERS LOG

date well completed 6-18 1968 firm name Switzer Well Co. county well located Harrison

LANDOWNER: Mrs. Syd. Davis
185 Gulf Stream Point Rd.
Biloxi, Miss.
(mailing address)

description of formations encountered	from to	
clay	0	24
mixed	24	42
clay	42	46
soft clay	46	68
mixed	68	90
clay	90	154
mixed	154	175
clay	175	269
fair sand	269	286
good sand	286	304


WELL LOCATION:
DIBERVILLE
sec 21 T 7 S R 9 E
2 miles N of BILOXI
(distance) (direction) (nearest town)

WELL PURPOSE: Home
(home, irrigation, municipal, industrial)

WELL COMPLETION DATA:

- (1) diameter (inches) 2
- (2) total depth (feet) 304
- (3) static water level (feet) 20 below above top of ground.
- (4) casing gal. steel 294'
(material) (depth)
2" if telescope see back.
(size)
- (5) screen 10' 294'
(length) (depth to top)
8 ga. 55 on pipe
(size) (material)
- (6) pump 1/2 8.5
(HP) (yield gpm)
electric
(type power)
- (7) electric log No
(yes or no)
(organization running log)
- (8) how well bottom plugged Back
pressure value

CODED

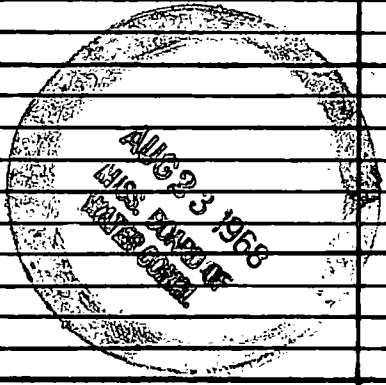


DRILLERS REMARKS:

If well telescopes please sketch and show depths.

01111

GROUND LEVEL

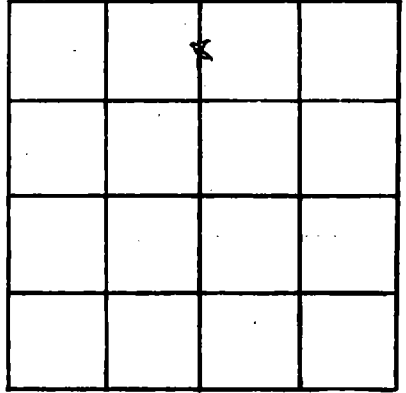

D I BERVILLE
SECTION _____

Please indicate well location X.

ADDITIONAL INFORMATION

If more than one screen, show locations of each on sketch.