

Harrison
M275
10-11-68

MISSISSIPPI
 BOARD OF WATER COMMISSIONERS
 416 North State Street
 Jackson, Mississippi 39201

CODED

WATER WELL DRILLERS LOG

date well completed 10-11 1968 firm name Switzer Well Co. county well located Harrison

LANDOWNER: John Atkinson

description of formations encountered	from	to
<u>fine sand</u>	<u>0</u>	<u>22</u>
<u>sand</u>	<u>22</u>	<u>32</u>
<u>clay</u>	<u>32</u>	<u>43</u>
<u>mixed</u>	<u>43</u>	<u>104</u>
<u>fine sand</u>	<u>104</u>	<u>125</u>
<u>fair sand</u>	<u>125</u>	<u>145</u>
<u>sand</u>	<u>145</u>	<u>154</u>
<u>clay</u>	<u>154</u>	<u>165</u>
<u>mixed</u>	<u>165</u>	<u>185</u>
<u>clay</u>	<u>185</u>	<u>206</u>
<u>milled</u>	<u>206</u>	<u>267</u>
<u>clay</u>	<u>267</u>	<u>307</u>
<u>mixed</u>	<u>307</u>	<u>473</u>
<u>fine sand</u>	<u>473</u>	<u>514</u>
<u>good sand</u>	<u>514</u>	<u>574</u>

Jim Money Road
Biloxi Miss 39531
 (mailing address)

WELL LOCATION:
 sec. 23 T 7 N R. 10 E
23 S W
 miles 1.5 (distance) direction EN of Biloxi (nearest town)

WELL PURPOSE: trailer park
 (home, irrigation, municipal, industrial)

WELL COMPLETION DATA:

- (1) diameter (inches) 2 x 4
- (2) total depth (feet) 574'
- (3) static water level (feet) 38 below/above top of ground.
- (4) casing gal. steel (material) 544' (depth)
2 x 4 (size) If telescope see back.
- (5) screen 30' (length) 544' (depth to top)
8 ga. (size) SS on pipe (material)
- (6) pump 1 (HP) 350 GPM (yield gpm)
electric (type power)
- (7) electric log No (yes or no)
 (organization running log)
- (8) how well bottom plugged Back pressure valve

CODED


JAN 29 1969

DRILLERS REMARKS:

MISS. BD. OF
 WATER COM.

If well telescopes please sketch and show depths.

GROUND LEVEL

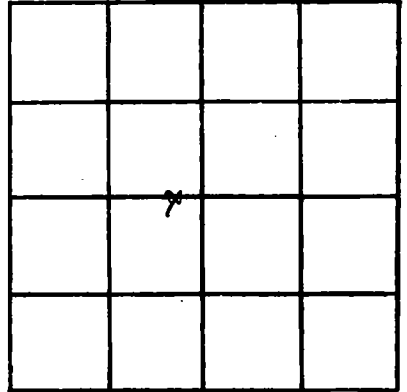

SECTION 23

Please indicate well location X.

ADDITIONAL INFORMATION

If more than one screen, show locations of each on sketch.