

Harrison
 M 279
 9-26-68

MISSISSIPPI
 BOARD OF WATER COMMISSIONERS
 416 North State Street
 Jackson, Mississippi 39201

CODED

WATER WELL DRILLERS LOG

9-26 1968 date well completed
 Lutter Well Works firm name
 Harrison county well located

LANDOWNER: Sam Broadus
 + Dewey Kuhn
 Rt. 1

description of formations encountered	from to	
	feet	feet
Clay	0	10
Sand	10	36
Clay	36	180
Sand	180	186
Clay	186	404
Sand	404	472

Biloxi
 (mailing address)

WELL LOCATION:
 sec. 1 T. 7 N. R. 10 E.
 S W

_____ miles of _____ of _____
 (distance) (direction) (nearest town)

WELL PURPOSE: home
 (home, irrigation, municipal, industrial)


- WELL COMPLETION DATA:
- (1) diameter (inches) 2
 - (2) total depth (feet) 472
 - (3) static water level (feet) 21 below above-top of ground.
 - (4) casing Galv. 462'
 (material) (depth)
2"
 (size) if telescope see back.
 - (5) screen 10 462'
 (length) (depth to top)
2" stainless steel
 (size) (material)
 - (6) pump unknown
 (HP) (yield gpm)

CODED

- (7) electric log no
 (yes or no)
- (organization running log)

(8) how well bottom plugged BPU

DRILLERS REMARKS:

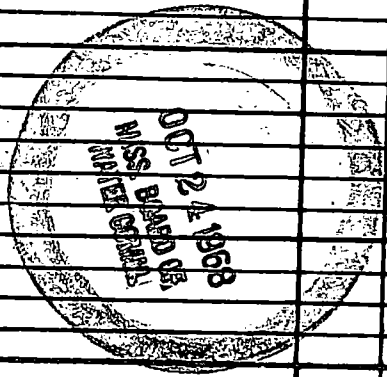

If well telescopes please sketch and show depths.

GROUND LEVEL

SECTION _____

Please indicate well location X.

ADDITIONAL INFORMATION

If more than one screen, show locations of each on sketch.