

Harrison
M280
9-27-68

MISSISSIPPI
 BOARD OF WATER COMMISSIONERS
 416 North State Street
 Jackson, Mississippi 39201

CODED

WATER WELL DRILLERS LOG

9-27 1968 Butler Well Works Harrison
 date well completed firm name county well located

LANDOWNER: Jos. Sherman
Gay Rd
Biloxi
 (mailing address)


description of formations encountered	from	to
<u>Clay</u>	<u>0</u>	<u>8</u>
<u>sand</u>	<u>8</u>	<u>30</u>
<u>Clay</u>	<u>30</u>	<u>141</u>
<u>sand</u>	<u>141</u>	<u>156</u>
<u>Clay</u>	<u>156</u>	<u>263</u>
<u>sand</u>	<u>263</u>	<u>338</u>

WELL LOCATION:
 sec. 1 T. 1 N. R. 9 E
S W
 _____ miles _____ of _____
 (distance) (direction) (nearest town)

WELL PURPOSE: trailer park
 (home, irrigation, municipal, industrial)

- WELL COMPLETION DATA:
- (1) diameter (inches) 2 x 4
 - (2) total depth (feet) 338
 - (3) static water level (feet) 27 below above top of ground.
 - (4) casing galv. 318'
 (material) (depth)
2 x 4 If telescope see back.
 (size)
 - (5) screen 20' 318
 (length) (depth to top)
2" Stainless steel
 (size) (material)
 - (6) pump 2 inman
 (HP) (yield gpm)
elec
 (type power)
 - (7) electric log no
 (yes or no)
 - (8) how well bottom plugged B.P. valve

CODED

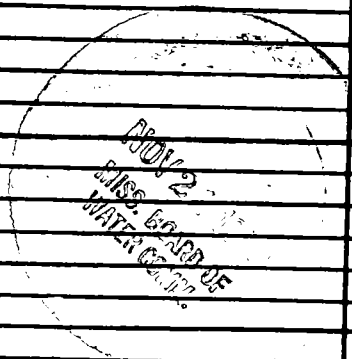

DRILLERS REMARKS:


If well telescopes please sketch and show depths.

GROUND LEVEL

105' of 4"

2" casing

2x20 SS Struc

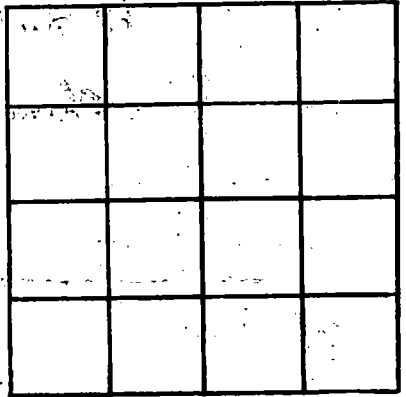

SECTION _____

Please indicate well location X.

ADDITIONAL INFORMATION

If more than one screen, show locations of each on sketch.