

Harrison
 M 281
 10-10-68

MISSISSIPPI
 BOARD OF WATER COMMISSIONERS
 416 North State Street
 Jackson, Mississippi 39201

CODED

WATER WELL DRILLERS LOG

10-10-1968 date well completed
 Lutter Well Works firm name
 Harrison county well located

LANDOWNER: Howard Lamey
 Rt. 2 Box 60

description of formations encountered	depth	
	from	to
Clay	0	21
sand	21	46
Clay	46	78
sand	78	90
Clay	90	257
sand	257	270
Clay	270	339
sand	339	379


Biloxi Miss.
 (mailing address)

WELL LOCATION:
 sec. 9 T. 7 N R. 9 E
 S W
 miles North of Biloxi
 (distance) (direction) (nearest town)

WELL PURPOSE: home
 (home, irrigation, municipal, industrial)

- WELL COMPLETION DATA:
- (1) diameter (inches) 2
 - (2) total depth (feet) 379
 - (3) static water level (feet) 19 below top of ground.
 - (4) casing galv. 369' (material) (depth)
 2" (size) If telescope see back.
 - (5) screen 10' 369' (length) (depth to top)
 2" Stainless Steel (size) (material)
 - (6) pump 1 15 (HP) (yield gpm)
 elec (type power)
 - (7) electric log no (yes or no)
 - (organization running log)
 - (8) how well bottom plugged BPU value

CODED

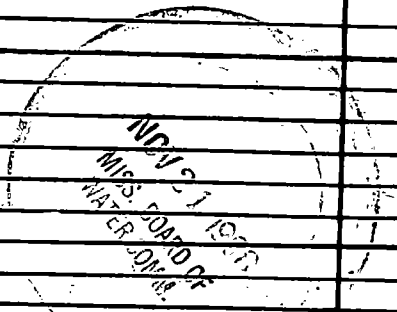

DRILLERS REMARKS:

If well telescopes please sketch and show depths.

GROUND LEVEL

SECTION _____

Please indicate well location X.

ADDITIONAL INFORMATION

If more than one screen,
show locations of each on sketch.