

right off Lamey  
Bridge Rd.

Harrison  
M 287  
8-14-68

MISSISSIPPI  
BOARD OF WATER COMMISSIONERS  
416 North State Street  
Jackson, Mississippi 39201

**CODED**

WATER WELL DRILLERS LOG

8-14 1968 Switzer Well Co. Harrison  
date well completed firm name county well located

LANDOWNER: Thomas Laing

description of formations encountered

from to

Bachman Road

Mixed

0 62

Biloxi, Miss.

Clay

62 83

(mailing address)

Mixed

83 103

Fair sand

103 121

WELL LOCATION:

sec. 9 T. 7 S. R. 9 W.  
2 miles N of Biloxi  
(distance) (direction) (nearest town)

WELL PURPOSE: Home  
(home, irrigation, municipal, industrial)

WELL COMPLETION DATA:

- (1) diameter (inches) 2
- (2) total depth (feet) 120
- (3) static water level (feet) 36 below above top of ground.
- (4) casing gal. steel, 110',  
(material) (depth)  
2" if telescope see back.  
(size)
- (5) screen 10', 110'  
(length) (depth to top)  
8ga., SS on pipe  
(size) (material)
- (6) pump 1/2 8.5  
(HP) (yield gpm) GPM  
electric 6PM  
(type power)
- (7) electric log No  
(yes or no)

**CODED**


(organization running log)  
(8) how well bottom plugged back  
pressure valve

DRILLERS REMARKS:

**NO CODED**  
MISS. BD. OF  
WATER COMM.

If well telescopes please sketch and show depths.

GROUND LEVEL

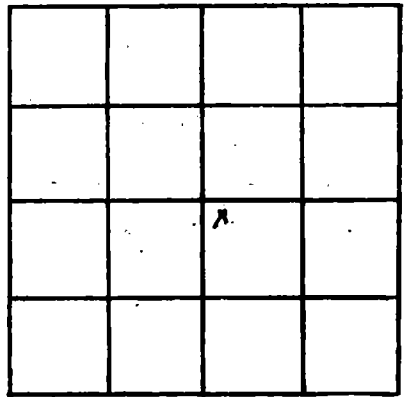

SECTION 9

Please indicate well location X.

ADDITIONAL INFORMATION

If more than one screen, show locations of each on sketch.