

Harrison  
 M 289  
 8-24-68  
 M.G.S.

MISSISSIPPI  
 BOARD OF WATER COMMISSIONERS  
 416 North State Street  
 Jackson, Mississippi 39201

**CODED**

WATER WELL DRILLERS LOG

Aug 24 1968 M & B Drilling Co. Harrison  
 date well completed firm name county well located

LANDOWNER: Mr. Mc Clanahan  
Service Contracting, Inc  
Harvey, La. - Peters Rd.  
 (mailing address)

WELL LOCATION:  
 sec. 12 T. 7 S. R. 10 W.  
3 miles NW of B. Iori  
 (distance) (direction) (nearest town)

WELL PURPOSE: Farm Home  
 (home, irrigation, municipal, industrial)

WELL COMPLETION DATA:

- (1) diameter (inches) 4
- (2) total depth (feet) 777
- (3) static water level (feet) 12 below above  
top of ground.
- (4) casing Steel 777  
(material) (depth)  
4" if telescope see back.  
(size)
- (5) screen 20 777  
(length) (depth to top)  
4" 5. Steel 1010-1/2"  
(size) (material)
- (6) pump 1 25  
(HP) (yield gpm)  
220 1/2 Shallow Well  
(type power) 2 stage
- (7) electric log Yes  
(yes or no)  
Miss. Geological Survey  
(organization running log)
- (8) how well bottom plugged 4" Back  
Wash 1/2"

description of formations encountered	from	to
Surface	0	14
White Sand	14	25
Blue Clay	25	57
Sand	57	57
Blue Clay	57	90
Sand	90	100
Blue Clay	100	220
Sand	220	235
Blue Clay	235	240
Sand	240	260
Blue Clay	260	280
Sand	280	290
Blue Clay	290	415
Fine Sand	415	440
Coarse Sand	440	560
Blue Clay	560	580
Fine Sand	580	590
Blue Clay	590	650
Sand	650	670
<del>Blue Clay</del>	670	685
Sand	685	720
Coarse Sand	720	825
Blue Clay	825	825
Sand	825	900
Clay	900	950
Sand	950	1020
Fine Sand & Clay Brecker	1020	1155
Hard Clay	1155	1267

**CODED**


DEC 10 1968

MISS. BD. OF  
 COMING

DRILLERS REMARKS:

If well telescopes please sketch and show depths.

GROUND LEVEL

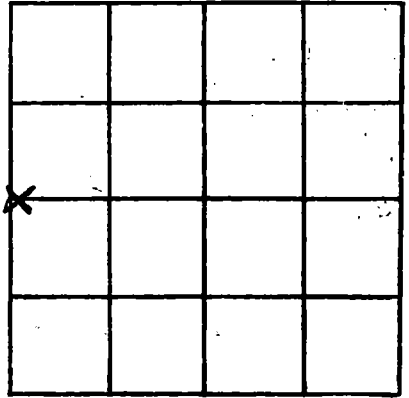

SECTION 12

Please indicate well location X.

ADDITIONAL INFORMATION

If more than one screen, show locations of each on sketch.