

Harrison
 M 293
 2-69

MISSISSIPPI
 BOARD OF WATER COMMISSIONERS
 416 North State Street
 Jackson, Mississippi 39201

CODED

WATER WELL DRILLERS LOG

2/22 1969 Coastal Drilling HARRISON
 date well completed firm name county well located

LANDOWNER: Jene
Ornn Rt 1 Bx 951
N. Biloxi, Miss
 (mailing address)

WELL LOCATION:
 sec. 8 T. 7 N. R. 9 E.
2 miles N of Biloxi
 (distance) (direction) (nearest town)

description of formations encountered	from	to
Red Clay	1	10
Blue Clay	10	20
White Sand	20	35
Blue Clay	35	275
fine water sand	275	290
very hard clay	290	350
fine sand	350	360
very coarse sand	360	392

WELL PURPOSE: home
 (home, irrigation, municipal, industrial)

WELL COMPLETION DATA:

- (1) diameter (inches) 2"
- (2) total depth (feet) 392
- (3) static water level (feet) _____ below above top of ground.
- (4) casing _____ (material) _____ (depth) _____
 _____ (size) If telescope see back.
- (5) screen 10 SS
 (length) (depth to top)
2" SS
 (size) (material)
- (6) pump None 18
 (HP) (yield gpm)
Ele
 (type power)
- (7) electric log _____ (yes or no)
 _____ (organization running log)
- (8) how well bottom plugged good

CODED

MAR 10 1969


DRILLERS REMARKS:

None

MISS. BD. OF
 WATER COMMISSIONERS

If well telescopes please sketch and show depths.

GROUND LEVEL

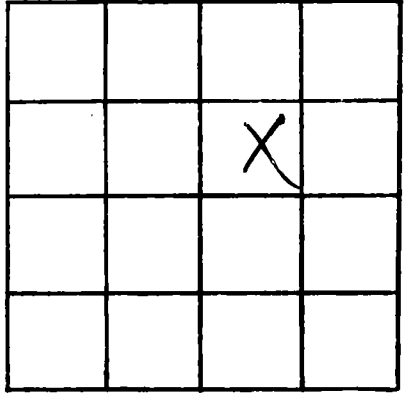

SECTION _____

Please indicate well location X.

ADDITIONAL INFORMATION

Lined area for additional information.

If more than one screen, show locations of each on sketch.