

Harrison
M 294
12-18-68

MISSISSIPPI
 BOARD OF WATER COMMISSIONERS
 416 North State Street
 Jackson, Mississippi 39201
 WATER WELL DRILLERS LOG

CODED

12-18 1968 Switzer) Hell Co. Harrison
 date well completed firm name county well located

LANDOWNER: City of Biloxi
Miller Park - Well #1
Biloxi, Miss.
 (mailing address)

description of formations encountered	from	to
<u>Mixed</u>	<u>0</u>	<u>85</u>
<u>fine sand</u>	<u>85</u>	<u>105</u>
<u>sand</u>	<u>105</u>	<u>113</u>
<u>clay</u>	<u>113</u>	<u>154</u>
<u>fine sand</u>	<u>154</u>	<u>166</u>
<u>sand</u>	<u>166</u>	<u>174</u>
<u>clay</u>	<u>174</u>	<u>177</u>
<u>sand</u>	<u>177</u>	<u>186</u>
<u>mixed</u>	<u>186</u>	<u>208</u>
<u>clay</u>	<u>208</u>	<u>288</u>
<u>fine sand</u>	<u>288</u>	<u>291</u>
<u>sand</u>	<u>291</u>	<u>295</u>
<u>clay</u>	<u>295</u>	<u>310</u>
<u>mixed</u>	<u>310</u>	<u>365</u>
<u>fine sand</u>	<u>365</u>	<u>405</u>
<u>good sand</u>	<u>405</u>	<u>429</u>

WELL LOCATION:
 sec. 23 T. 7 S. R. 10 E. W.
IN BILOXI
 (distance) miles (direction) of (nearest town)

WELL PURPOSE: Municipal
 (home, irrigation, municipal, industrial)

WELL COMPLETION DATA:

(1) diameter (inches) 2 x 4

(2) total depth (feet) 429

(3) static water level (feet) 16 below above top of ground.

(4) casing gal steel, 409' (material) (depth)
2 x 4 If telescope see back. (size)

(5) screen 20' (length) 409' (depth to top)
900 (size) 55 on pipe (material)

(6) pump 3/4 (HP) 600 (yield gph)
electric (type power)

(7) electric log no (yes or no)
 (organization running log)

(8) how well bottom plugged Back
pressure valve

DRILLERS REMARKS:


APR 18 1969

If well telescopes please sketch and show depths.

GROUND LEVEL

105' OF 4"

324' OF 2"

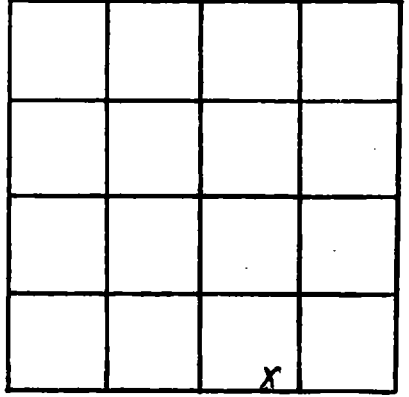

SECTION ~~27~~ 23

Please indicate well location X.

ADDITIONAL INFORMATION

If more than one screen, show locations of each on sketch.