

Harrison
M297
12-24-68

MISSISSIPPI
 BOARD OF WATER COMMISSIONERS
 416 North State Street
 Jackson, Mississippi 39201

CODED

WATER WELL DRILLERS LOG

12-24 1968 Switzer Well Co. Harrison
 date well completed firm name county well located

LANDOWNER: City of Biloxi

description of formations encountered

from to

Miller Park - Well #3

mixed

0 64

Biloxi, Miss.
 (mailing address)

clay

64 85

mixed

85 105

fine sand

105 126

sand

126 128

clay

128 155

fine sand

155 167

sand

167 184

clay

184 250

mixed

250 287

clay

287 305

mixed

305 326

clay

326 346

fine sand

346 387

sand

387 389

clay

389 409

good sand

409 469

WELL LOCATION:

sec. 26 T. 7 N. R. 10 E
 S W
IN miles Biloxi of
 (distance) (direction) (nearest town)

WELL PURPOSE: Municipal
 (home, irrigation, municipal, industrial)

WELL COMPLETION DATA:

- (1) diameter (inches) 2 x 4
- (2) total depth (feet) 469'
- (3) static water level (feet) 23 below above top of ground.
- (4) casing gal. steel 439'
 (material) (depth)
- 2 x 4 if telescope see back.
 (size)
- (5) screen 30', 439'
 (length) (depth to top)
- 800, 55 on pipe
 (size) (material)
- (6) pump 2 32
 (HP) (yield gpm)
- electric
 (type power)
- (7) electric log No
 (yes or no)

(organization running log)

(8) how well bottom plugged Back pressure valve

DRILLERS REMARKS:

APR 18 1969


MISS. BD. OF
 WATER COM. M.

If well telescopes please sketch and show depths.

GROUND LEVEL

105' OF 4"

334' OF 2"

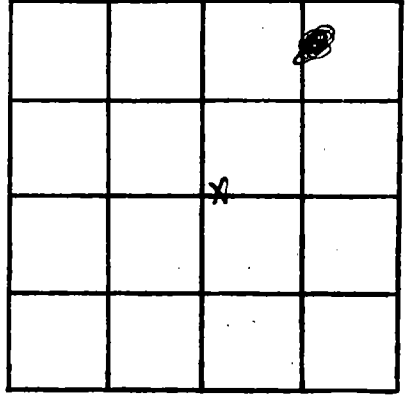

SECTION 26

Please indicate well location X.

ADDITIONAL INFORMATION

If more than one screen, show locations of each on sketch.