

Harrison
 M 300
 4-28-69

MISSISSIPPI
 BOARD OF WATER COMMISSIONERS
 416 North State Street
 Jackson, Mississippi 39201

CODED

WATER WELL DRILLERS LOG

April 28 1969 Max B Drilling Co. Harrison
 date well completed firm name county well located

LANDOWNER: Oakleigh Utilities
 P.O. Box 1469
 Gulfport, Miss.
 (mailing address)

WELL LOCATION:
 sec. 7 T. 2 S. R. 10 E
 4 miles N of Houndstooth
 (distance) (direction) (nearest town)

WELL PURPOSE: Subdivision
 (home, irrigation, municipal, industrial)

- WELL COMPLETION DATA:
- (1) diameter (inches) 6x4
 - (2) total depth (feet) 508
 - (3) static water level (feet) 17 below top of ground.
 - (4) casing PVC Total
 (material) (depth)
 6x4 if telescope see back.
 - (5) screen 20 488
 (length) (depth to top)
 4/4 Stainless Steel
 (size) (material)
 - (6) pump 10 200
 (HP) (yield gpm)
 200 3/4 300 gpm with 1/2" Thr.
 - (7) electric log No
 (yes or no)
 - (organization running log)
 - (8) how well bottom plugged 4" B.W.
 Check

description of formations encountered	from	to
Surface	0	5
White Clay	5	16
Grey Clay	16	35
Sand	35	60
Wood	55	60
White Clay White Sand	60	75
Yellow Clay	75	76
White Clay	76	90
Blue Clay	90	140
Dark Grey Clay	140	180
Blue Clay	180	200
Fine Sand & Clay Breaker	200	230
Blue Clay	230	260
Sand	260	275
Blue Clay	275	280
Sand & Clay Breaker	280	295
Blue Clay	295	350
Fine Sand	350	372
Blue Clay	372	430
Sand	430	508+
Sand 280 to 508		
Checks 81% Retainance on .025 Gauge		

1969

DRILLERS REMARKS:

MISS. BD. OF WATER COMMISSIONERS

If well telescopes please sketch and show depths.

GROUND LEVEL

145 FT
6" PVC
Sch 40

145 →

6x4 PVC
Bushing

44 PVC
Sch 40

488 →

20 FT S.S. Under
Screen

44 Female
Adapters


44
Screen

Top 5 FT
#016

Bottom 15 FT
#020

508 →

44 Back
Wash
Valve

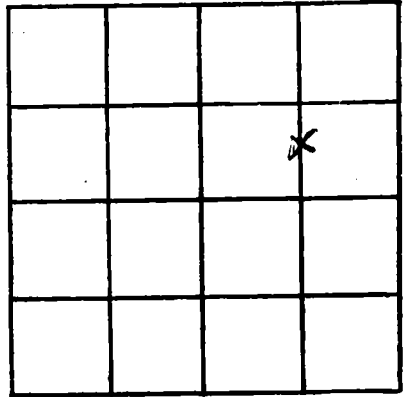

SECTION 7

Please indicate well location X.

ADDITIONAL INFORMATION

If more than one screen,
show locations of each on sketch.