

HARRISON
M 302
5-9-69

MISSISSIPPI
BOARD OF WATER COMMISSIONERS
416 North State Street
Jackson, Mississippi 39201

CODED

WATER WELL DRILLERS LOG

5/9/69 19
date well completed

Coastal Drilling
firm name

Harrison
county well located

LANDOWNER: M. A. Lowery

description of formations encountered

from to

Rt 3 of 260

white sand

1 30

Biloxi, Miss
(mailing address)

Blue Sand

30 45

fine blue sand

45 78

blue clay

78 304

water sand

304 315

Coarse water sand

315 346

WELL LOCATION:

sec 14 T 19 N R 9 E
S W
one miles N of Biloxi
(distance) (direction) (nearest town)

WELL PURPOSE: home
(home, irrigation, municipal, industrial)

WELL COMPLETION DATA:

- (1) diameter (inches) 2"
- (2) total depth (feet) 346'
- (3) static water level (feet) below top of ground.
- (4) casing (material) (depth)
If telescope see back.
(size)
- (5) screen 10' (length) (depth to top)
2" (size) SS (material)
- (6) pump 1/2 HP (HP) 17 (yield gpm)
Electric (type power)
- (7) electric log (yes or no)

CODED

(organization running log)

(8) how well bottom plugged good

JUL 31 1969


MISS. BD. OF
WATER COMM.

DRILLERS REMARKS:

None

If well telescopes please sketch and show depths.

GROUND LEVEL

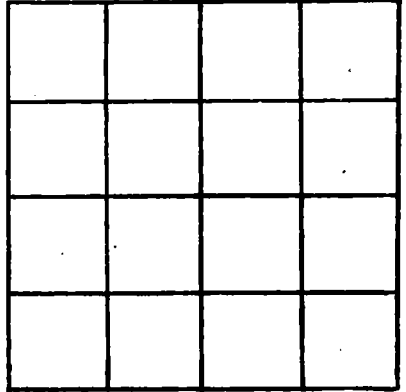

SECTION _____

Please indicate well location X.

ADDITIONAL INFORMATION

If more than one screen, show locations of each on sketch.