

CODED

MISSISSIPPI
BOARD OF WATER COMMISSIONERS
416 North State Street
Jackson, Mississippi 39201

WATER WELL DRILLERS LOG

Harrison
M304
6-21-69

6-21-69 19
date well completed

R. J. Moore
firm name

HARRISON
county well located

LANDOWNER: BAZIL SMITH

200 QUADRE RD

D'IBERVILLE, MISS
(mailing address)

WELL LOCATION:

sec. 16 T. 2 N R. 9 E
(S) (W)

ABOVE ACCESS
miles (distance) of (direction) (nearest town)

WELL PURPOSE: HOME
(home, irrigation, municipal, industrial)

WELL COMPLETION DATA:

(1) diameter (inches) 2"
(2) total depth (feet) 347'
(3) static water level (feet) 22' below top of ground.

(4) casing 9ALU 336'
(material) (depth)
(size) if telescope see back.

(5) screen 10' 336'
(length) (depth to top)
2" SS
(size) (material)


(6) pump 1 620
(HP) (yield gpm/hr)
ELECT
(type power)

(7) electric log (yes or no)
(organization running log)

(8) how well bottom plugged BCU
VALVE


description of formations encountered	from	to
TOP SOIL	0	12
WHITE SAND CLAY STRAITS	12	30
WHITE + Blue CLAY	30	60
FINE SAND + CLAY STRAITS	60	90
Blue CLAY	90	225
Blue SAND (med)	225	232
Blue CLAY	232	317
Blue SAND (med)	317	347

DRILLERS REMARKS:

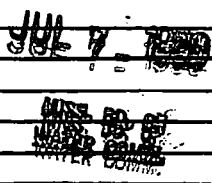

If well telescopes please sketch and show depths.

GROUND LEVEL

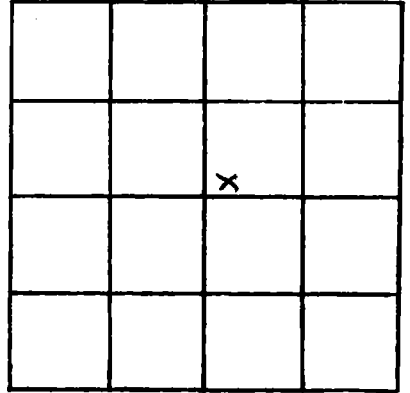

SECTION 16

Please indicate well location X.

ADDITIONAL INFORMATION

If more than one screen,
show locations of each on sketch.