

CODED

Harrison  
M310  
4-1-69

MISSISSIPPI  
BOARD OF WATER COMMISSIONERS  
416 North State Street  
Jackson, Mississippi 39201  
WATER WELL DRILLERS LOG

4-1 1969 date well completed  
Switzer Well Co. firm name  
Harrison county well located

LANDOWNER: Frank Brown  
308 Pringle Avenue  
Biloxi Miss.  
(mailing address)

description of formations encountered	from	to
clay	0	21
mixed	21	52
clay	52	73
fine sand	73	99
sand	99	101
clay	101	120
mixed	120	221
clay	221	243
mixed	243	306
clay	306	316
fine sand	316	326
fair sand	326	347
good sand	347	365

WELL LOCATION:

sec. 16 T. 7 A S R. 9 E W  
2 miles N of BILOXI  
(distance) (direction) (nearest town)

WELL PURPOSE: Home  
(home, irrigation, municipal, industrial)

WELL COMPLETION DATA:

- (1) diameter (inches) 2
- (2) total depth (feet) 364
- (3) static water level (feet) 23'10" below top of ground.
- (4) casing gal steel, 354' (material) (depth)  
2" (size) if telescope see back.
- (5) screen 10' (length), 354' (depth tp top)  
8 ga, ss on pipe (size) (material)
- (6) pump 1/2 (HP), 8.5 (yield gpm)  
electric (type power)
- (7) electric log No (yes or no)

(organization running log)

(8) how well bottom plugged back pressure valve


DRILLERS REMARKS:

SEP 19 1969

MISSISSIPPI BOARD OF WATER COMMISSIONERS

If well telescopes please sketch and show depths.

GROUND LEVEL

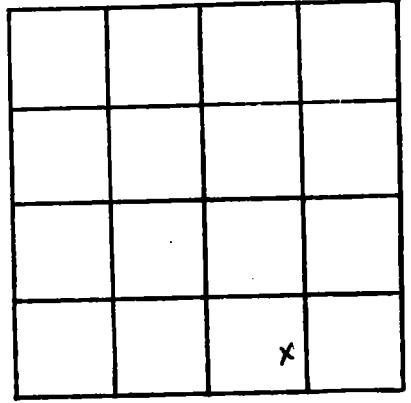

SECTION 16

Please indicate well location X.

ADDITIONAL INFORMATION

If more than one screen, show locations of each on sketch.